




25 22 21 20 19 18 10
D P 3 3 7 0 2 9

22 21 20 19
D P 3 1 3 5 6

DPS 66469

DPS 67143

Pt 2
DPS 43300

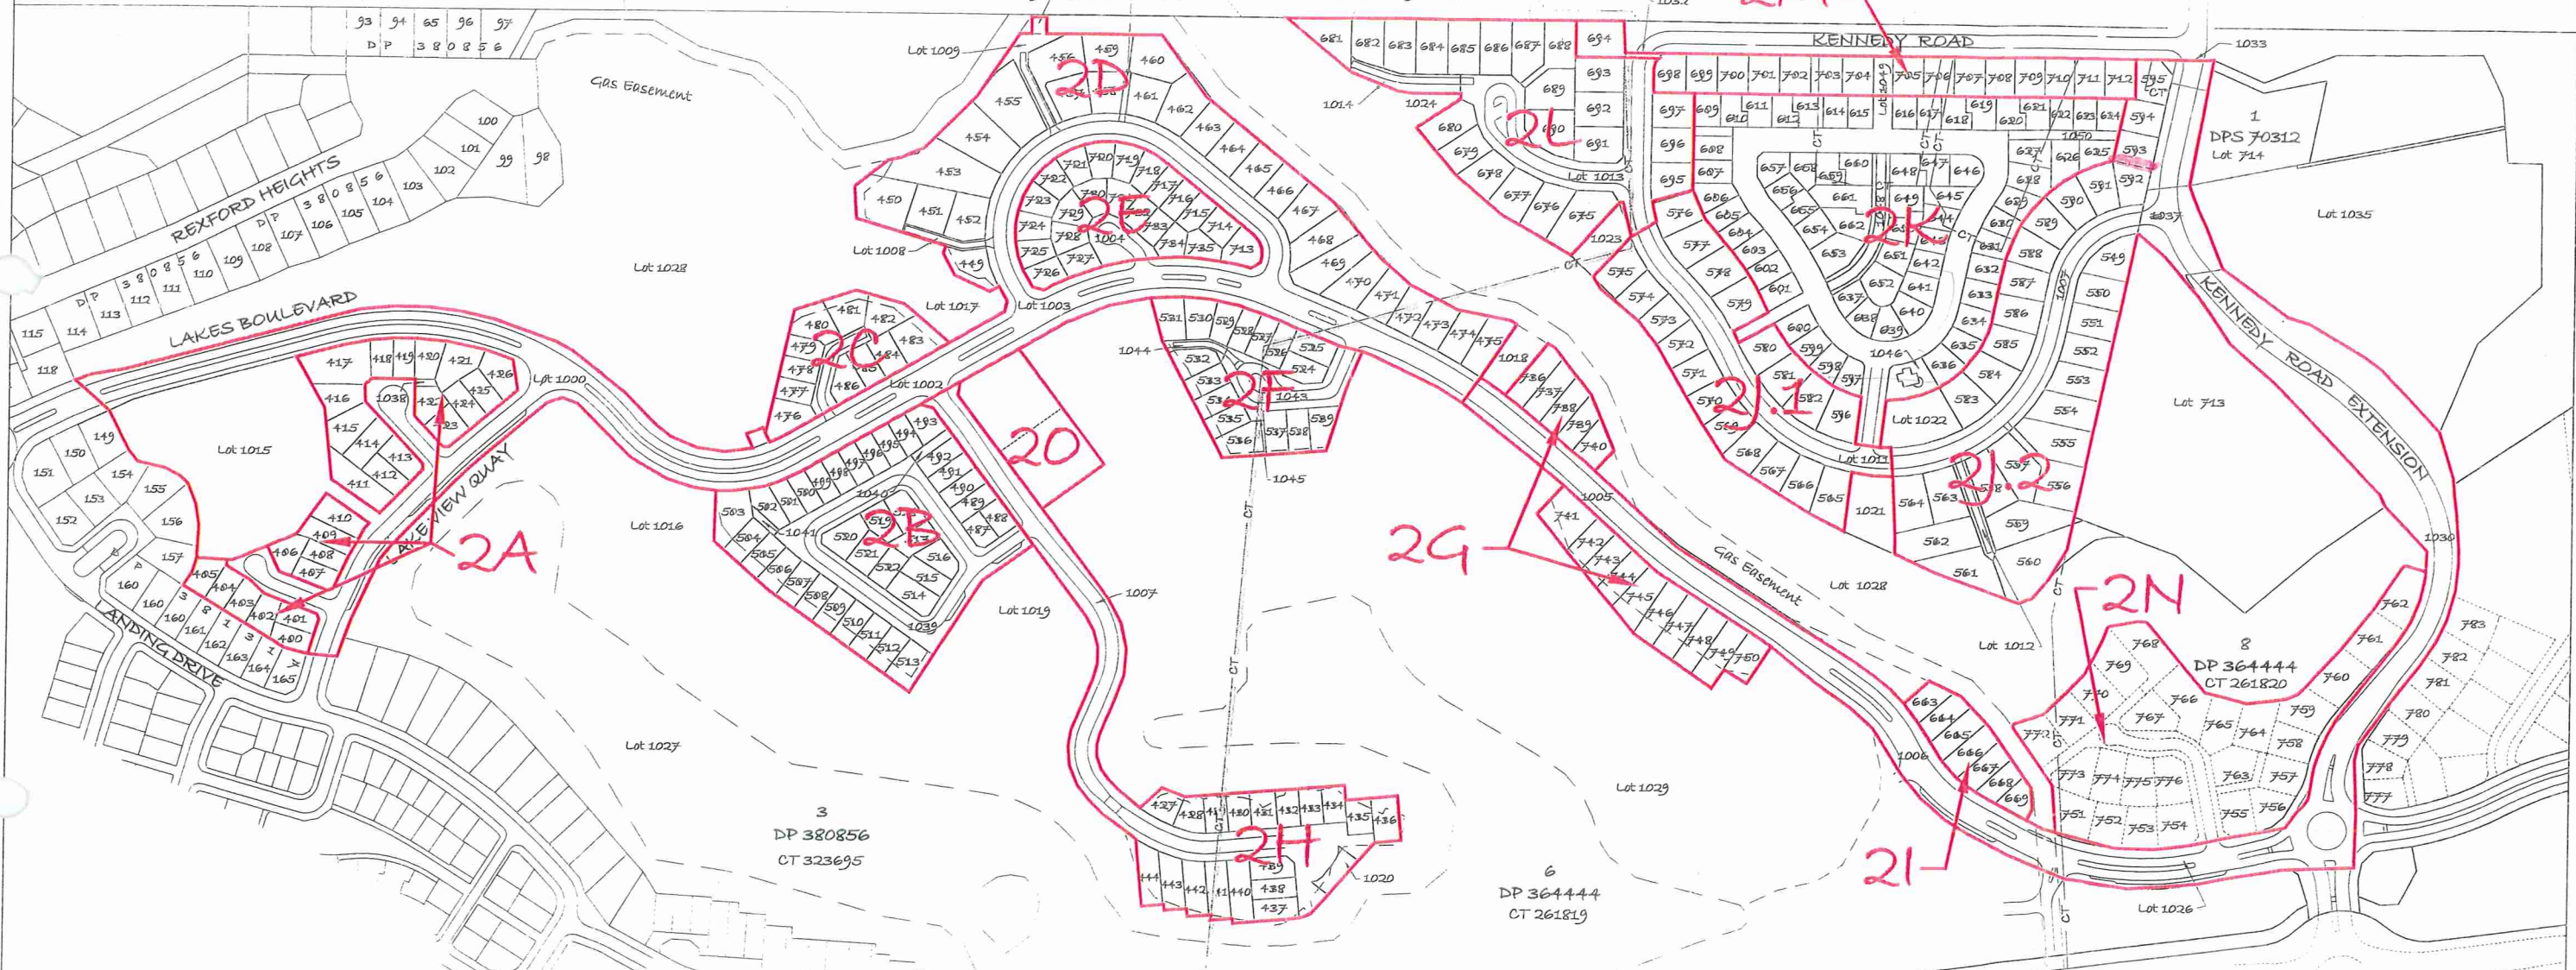

NOTE
There are no Lots 445 to 448, 523, 540 to 548, or 670 to 674 on this plan.

3
DP 380856
CT 323695



6
DP 364444
CT 261819

8
DP 364444
CT 261820

TAKITIMU DRIVE
Legal Road - 50.00m wide & over

957 -
DP 364444
LP Reserve (Segregation Strip)
vested in the WBOPDC


DESIGNED	DAT	SIGNATURE	PLT DATE
DRAWN	BY	SIGNATURE	DATE

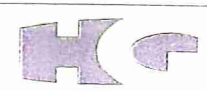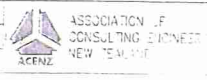

HARRISON
SPECIALISTS

THE LAKES
17/08/17

ASSIGNED
LOT NUMBERS

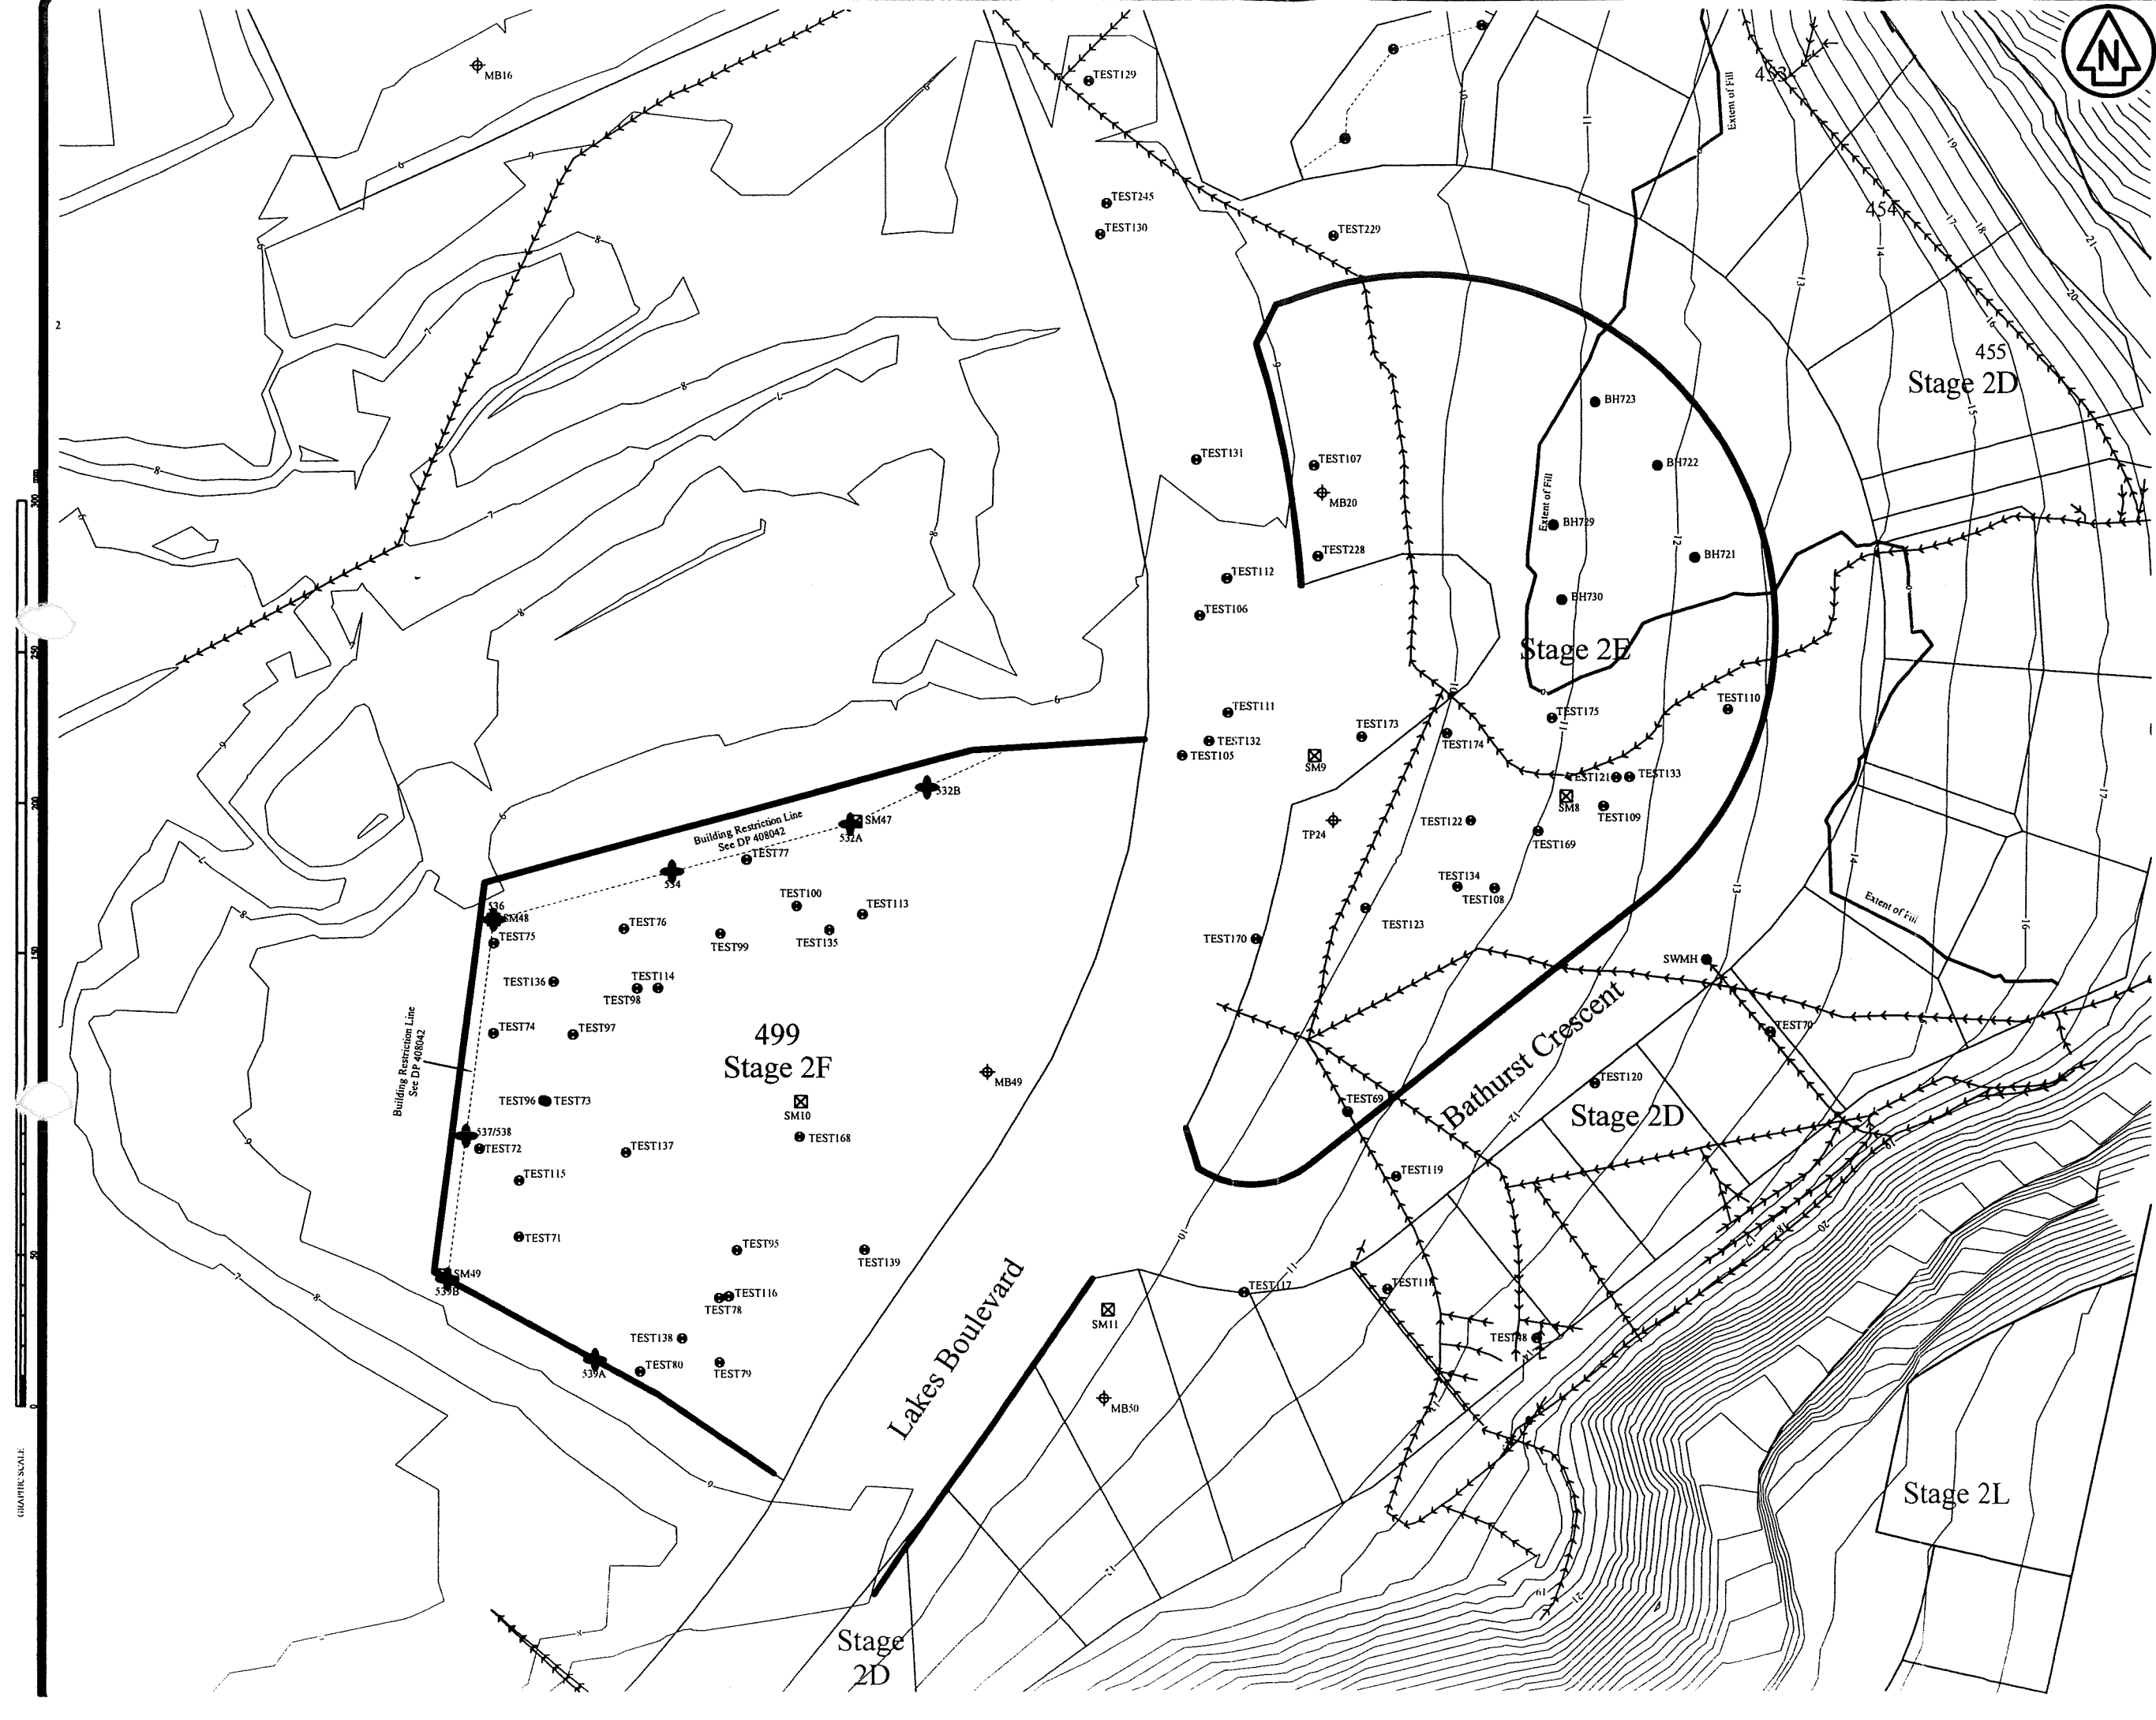

Notes:
1) Contours are in terms of Moturiki Datum

- Key
- Fill Compaction Test
 - ⊕ Pre-subdivision Test Site
 - ⊠ Settlement Control Marker
 - Post Earthwork Borehole
 - Subsoil Drain
 - ◆ Post Construction Borehole 02/08
 - Building Restriction Line

4	Issued for 2F Report Only	08/08
3	Issued for 224 Certificate	03/08
2	Subsoil Drains Amended	25/01/08
1	Issue with report	14/11/07


checked by	Rev. No.	Description	DATE
		NAME	DATE
Surveyed			
Designed		CJH	11/07
Drawn		MJH	11/07
Checked			
Approved			

REFERENCES




S & L CONSULTANTS LTD
SURVEYORS - ENGINEERS - PLANNERS
111 Cameron Road, Tauranga, New Zealand
P O Box 231 Ph.(07)577-6069
Fax(07)577-6065
Email: slconsultants@slta.co.nz

TITLE



Stage 2F
Geotechnical Report
Reference Plan

Copyright on this drawing is reserved	DATE
ORIGINAL SCALES 1:500 @ A1 1:1000 @ A3	11.07
DRAWING No. 18264-AB7	

GRAPHIC SCALE

GRAPHIC SCALE:



FILL Subdivision Cut and Fill Areas
 CUT
 1 — Fill Contour
 -1 — Cut Contour


3	Issued for 2F Report Only	08/08	
2	Issued for 224 Certificate	03/08	
1	Issue with Report	14/11/07	
checked by	Rev. No.	Description	DATE
		NAME	DATE
		SIGNED	
		Surveyed	
		Designed	CJH 11/07
		Drawn	MJH 11/07
		Checked	
		Approved	<i>[Signature]</i>



S & L CONSULTANTS LTD
 SURVEYORS - ENGINEERS - PLANNERS

111 Cameron Road, Tauranga, New Zealand
 P.O. Box 231 Ph.(07)577-6069
 Fax(07)577-6065
 Email: slconsultants@sliga.co.nz

TITLE




THE LAKES
 CONSULTANTS LTD


Stage 2F
 Earthworks Asbuilt
 Depth of Cut / Fill

Copyright in this drawing is reserved

ORIGINAL SCALES	DATE
1:500 @ A1	11 07
1:1000 @ A3	

DRAWING No.	
18264 - AB8	



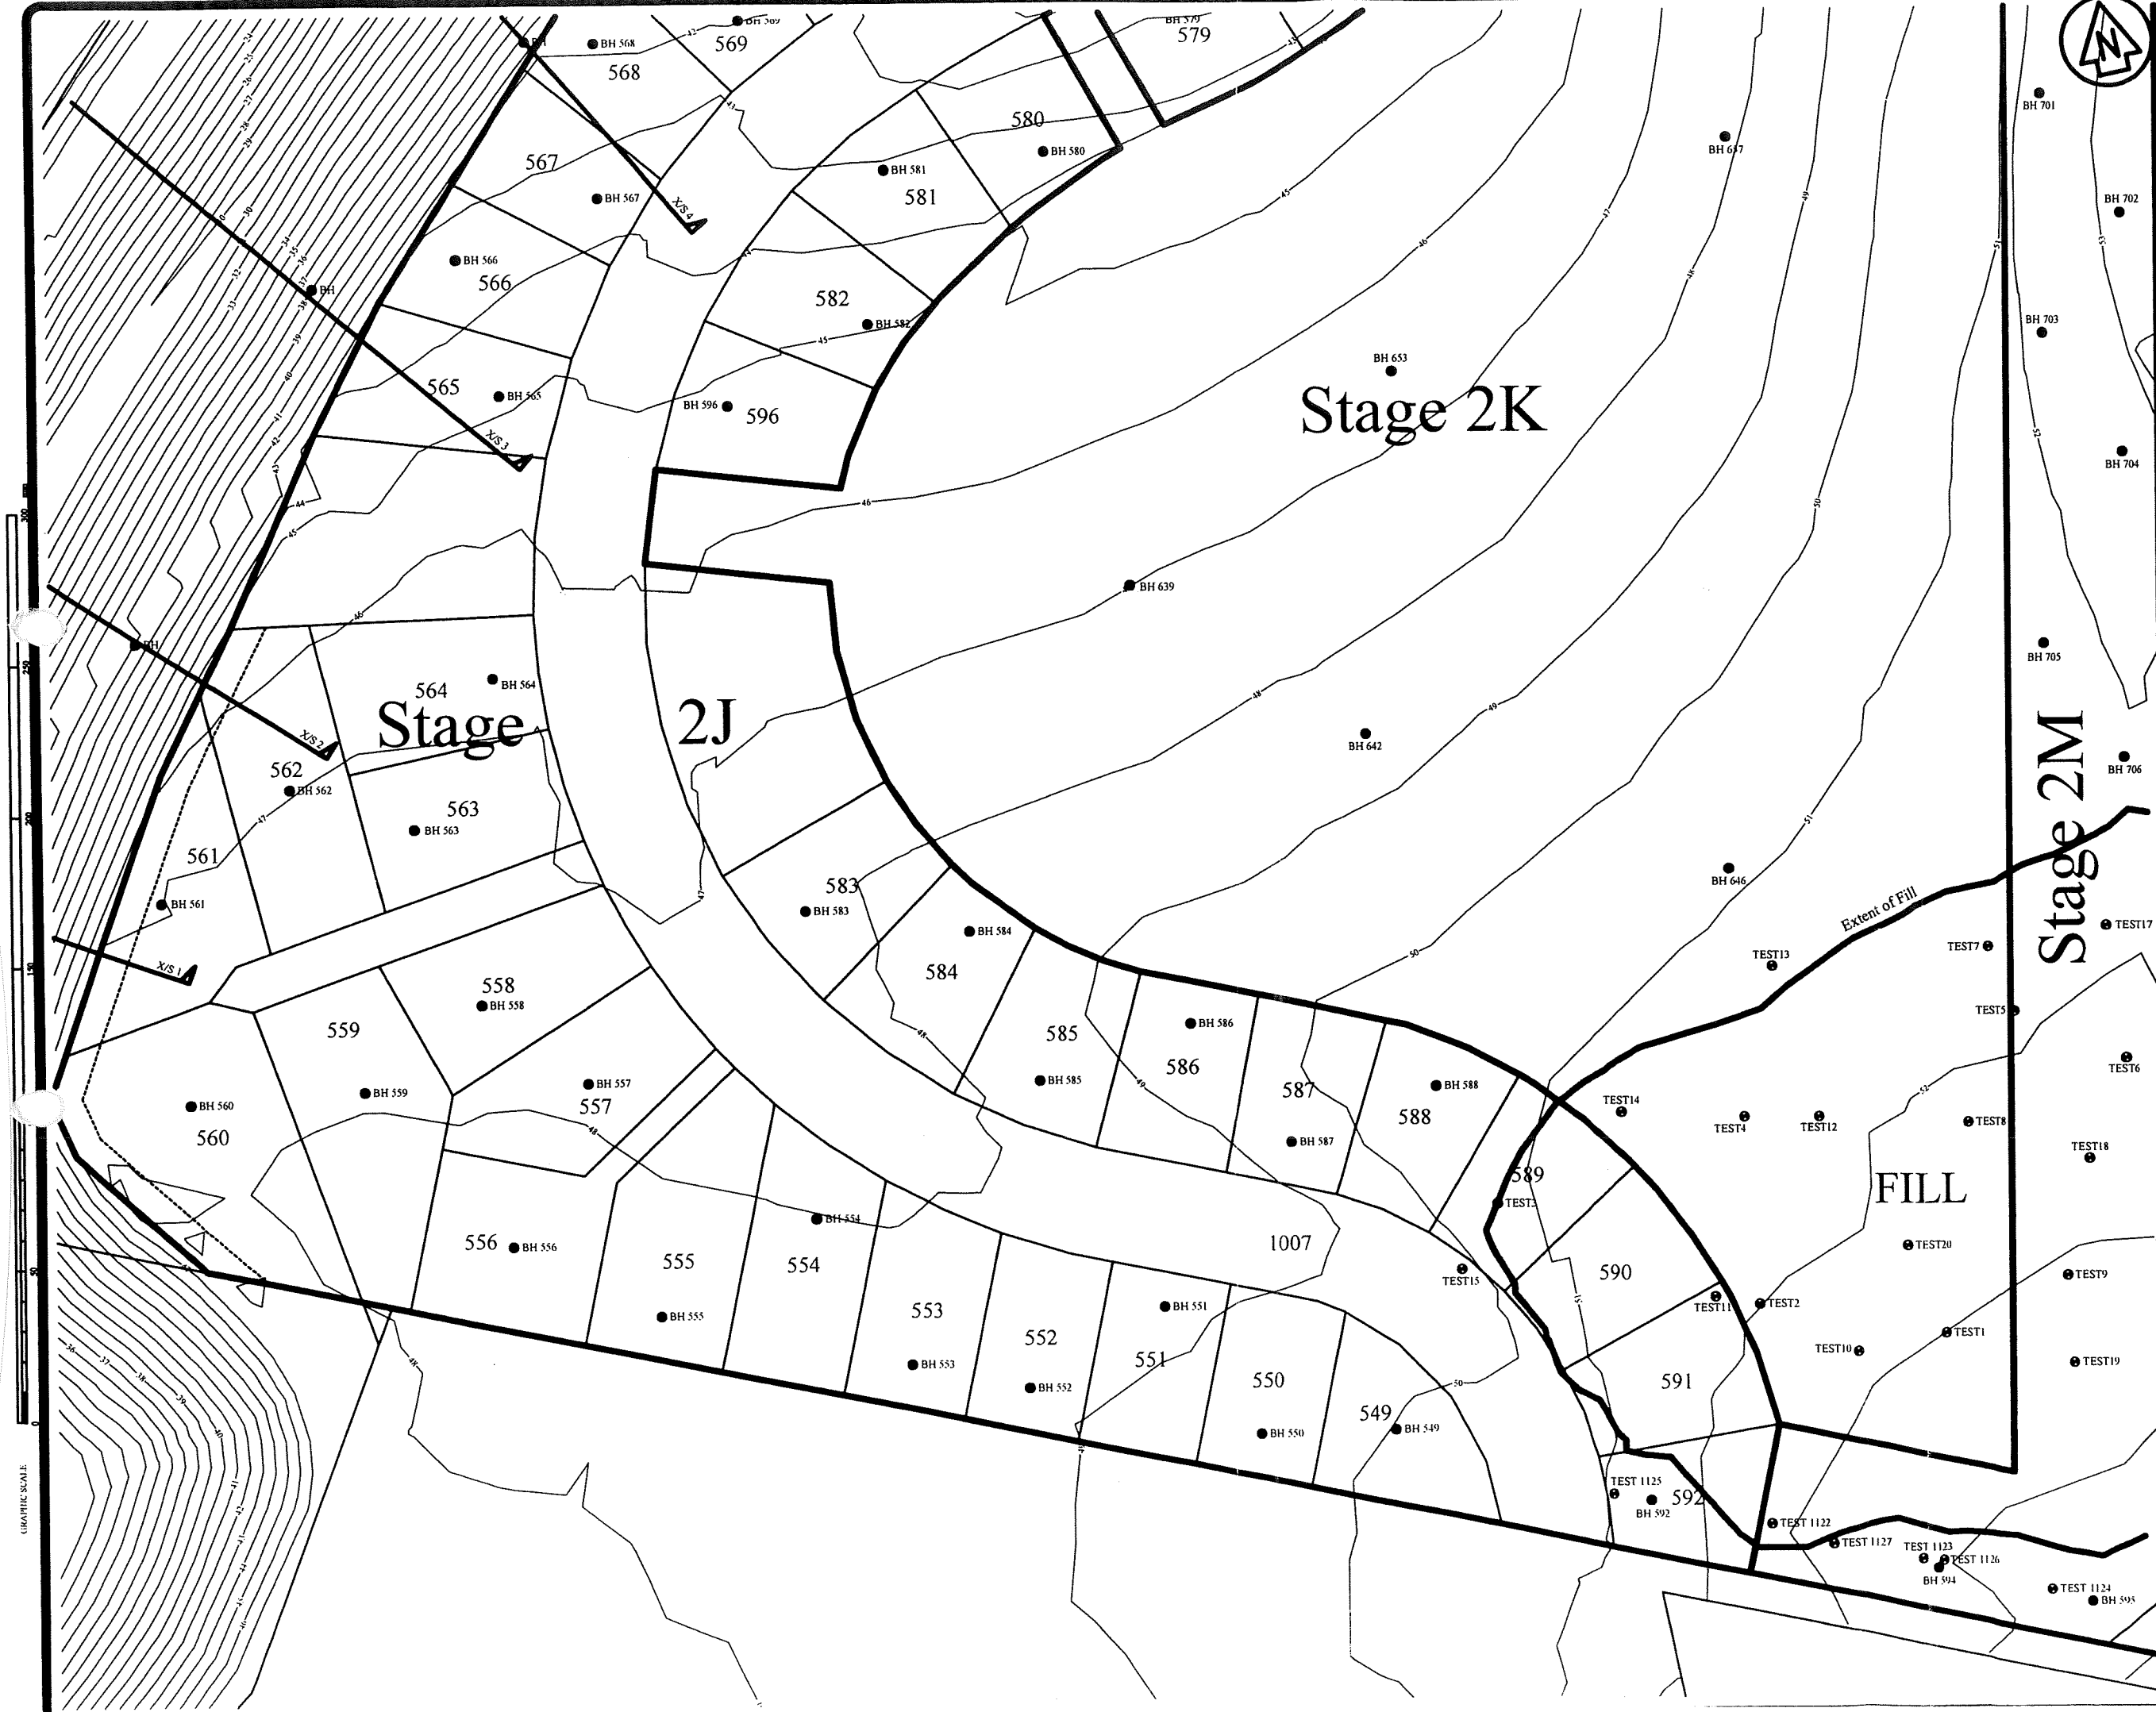

- Notes:
 1) Contours are in terms of Moturiki Datum
- Key
- Fill Compaction Test
 - ⊕ Pre-subdivision Test Site
 - ⊠ Settlement Control Marker
 - Post Earthwork Borehole
 - Subsoil Drain
 - Building Restriction Line
lots 560, 561 & 562 See DP 408042
other building restrictions on lots
565-568 are determined by
underground services
 - 3/ Analysed Cross Section

checked by	Rev. No.	Description	DATE
		Issued with Report	08/08
Surveyed			
Designed			
Drawn	GR		08/08
Checked	CH		08/08
Approved			

REFERENCES

S & L CONSULTANTS LTD
 SURVEYORS - ENGINEERS - PLANNERS

111 Cameron Road, Tauranga, New Zealand
 P.O. Box 231 Ph.(07)577-6069
 Fax(07)577-6065
 Email: slconsultants@slga.co.nz

TITLE

THE LAKES

Stages 2D(Part), 2G, 2J
 2K, 2L & 2M

Geotechnical Report
 Reference Plan

(Sheet 1 of 3)


Copyright in this drawing reserved

ORIGINAL SCALES	DATE
1:500 @ A1	08/08
1:1000 @ A3	

DRAWING No.

18264 - AB11

GRAPHIC SCALE

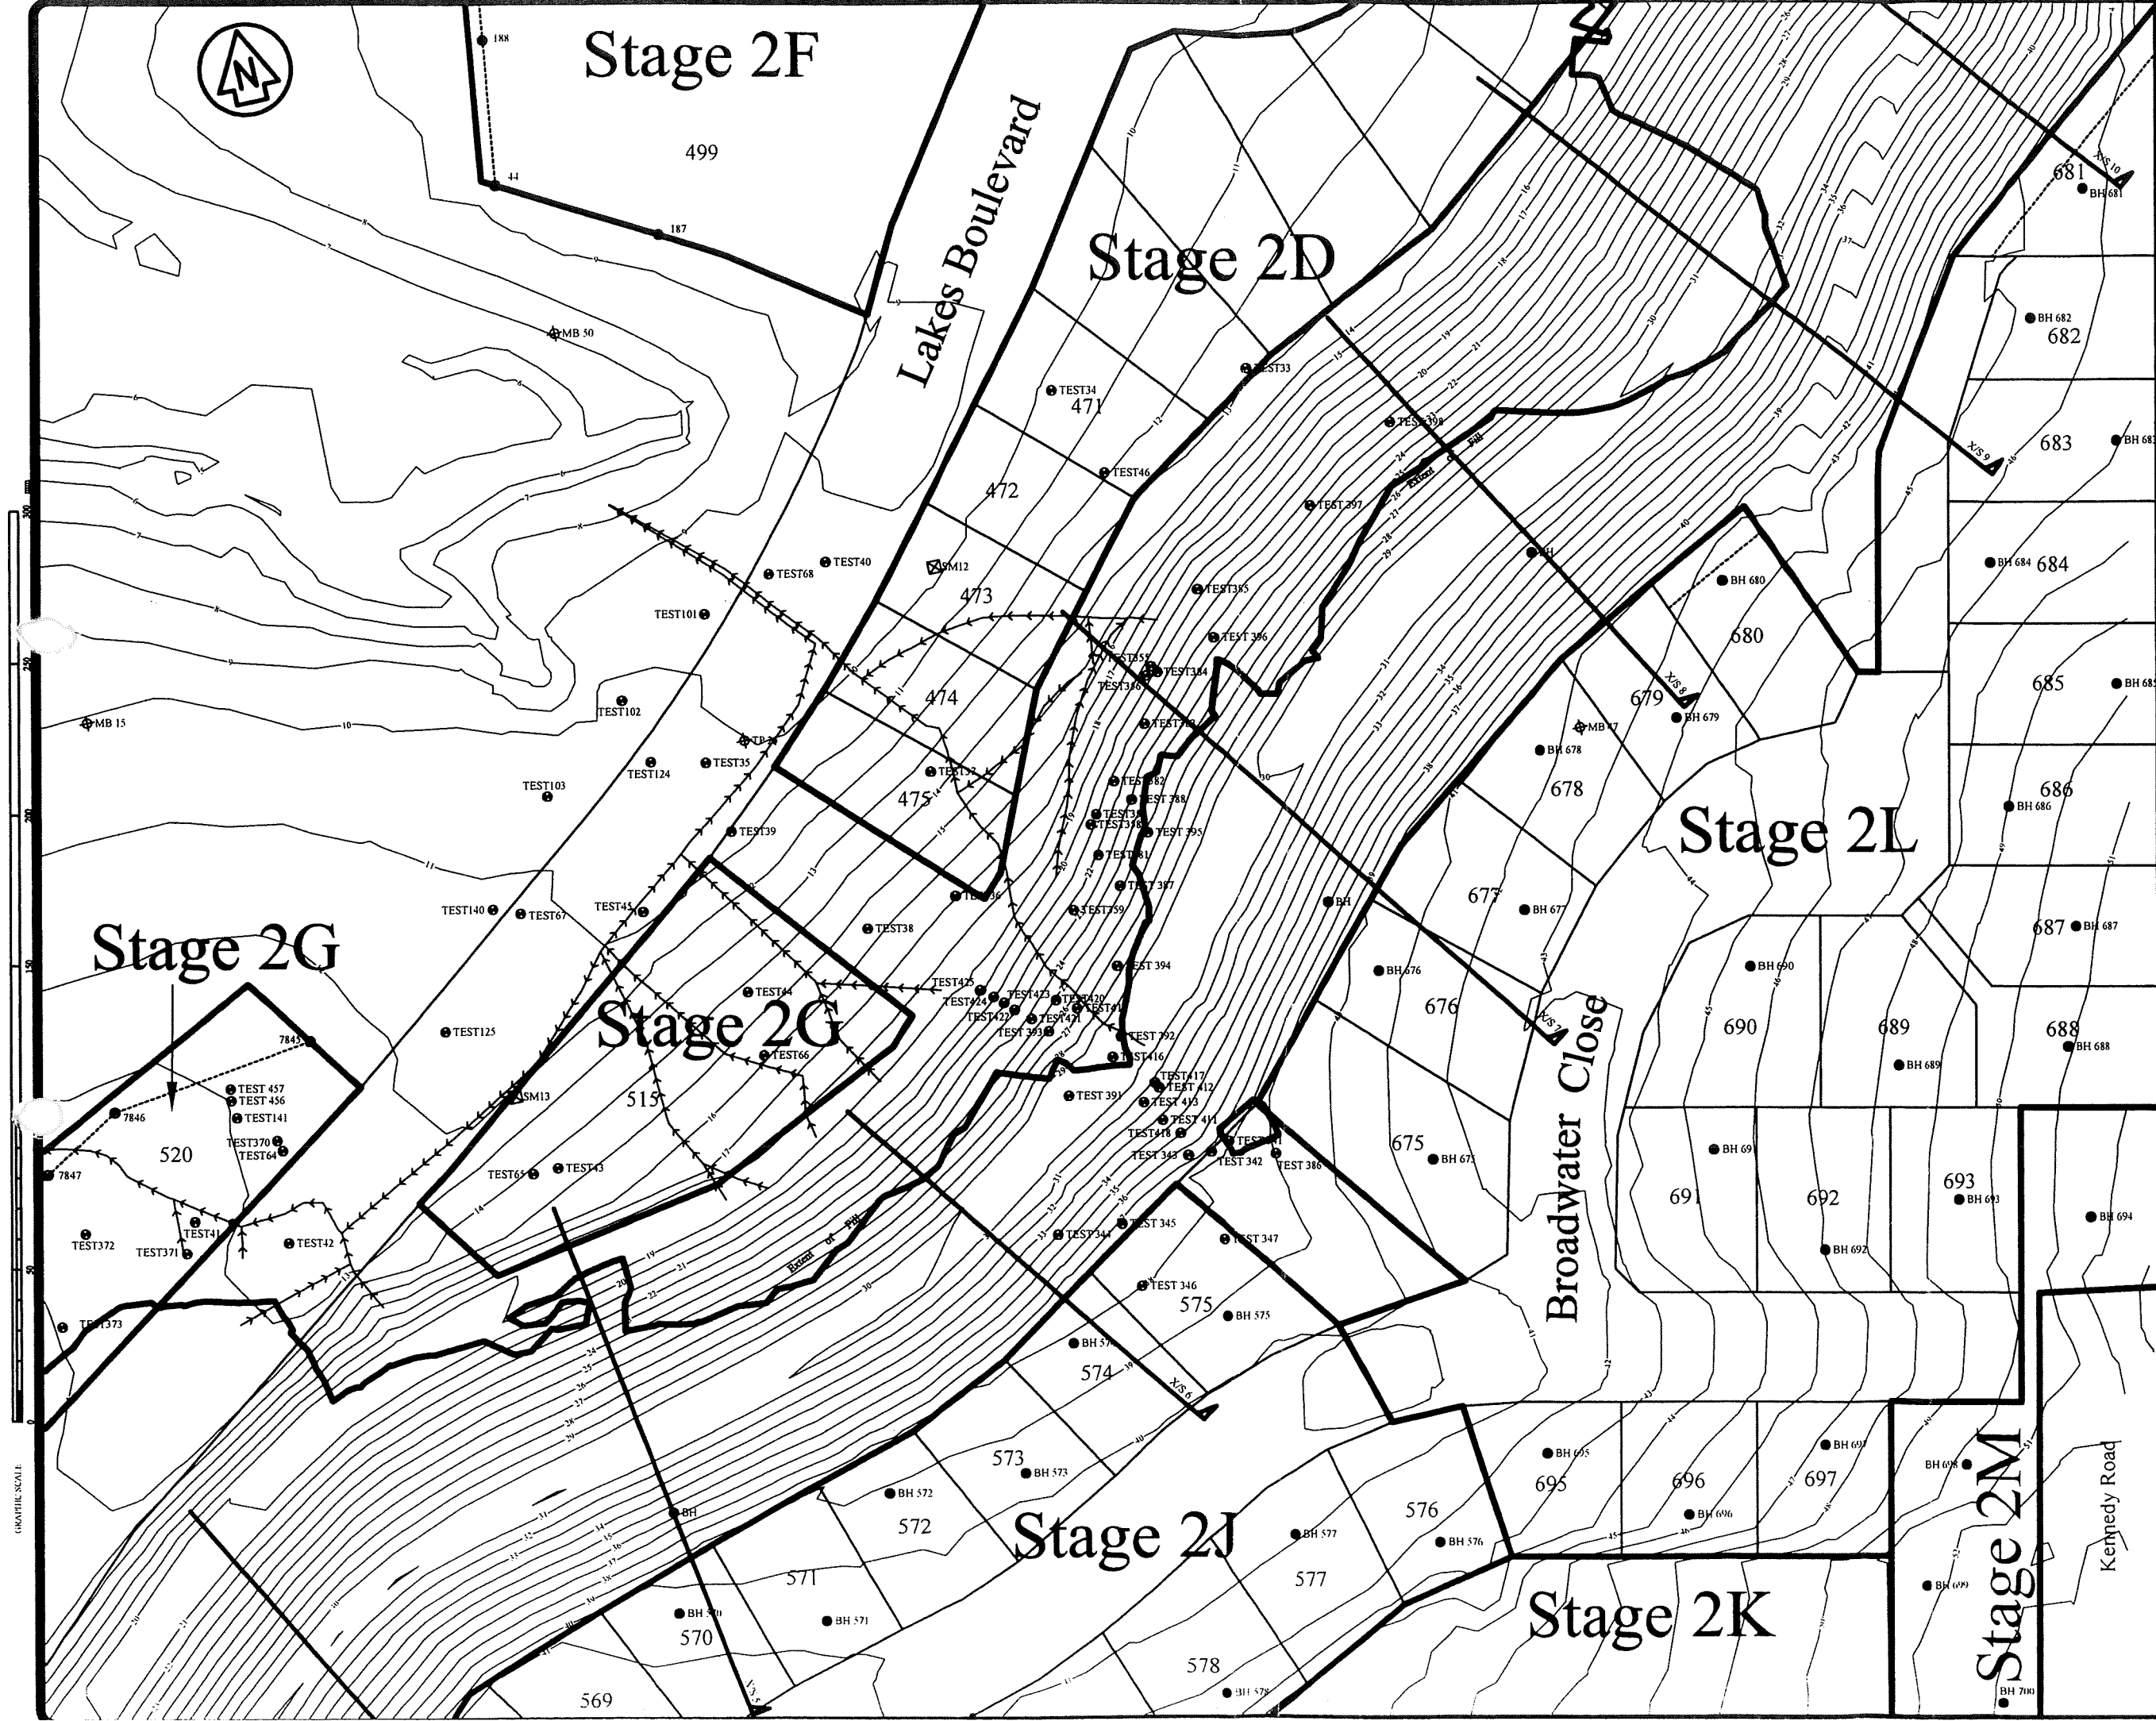

- Notes:
 1) Contours are in terms of Moturiki Datum
- Key
- Fill Compaction Test
 - ⊕ Pre-subdivision Test Site
 - ⊗ Settlement Control Marker
 - Post Earthwork Borehole
 - Subsoil Drain
 - Building Restriction Line
lots 520, 680 & 681 See DP 408042
other building restrictions on lots
569-575 & 675-679 are determined
by underground services

5 Analyzed Cross Section

checked by	Rev. No.	Description	DATE
Surveyed			
Designed			
Drawn	GR	08/08	
Checked	CH	08/08	
Approved			

REFERENCES



S & L CONSULTANTS LTD
 SURVEYORS - ENGINEERS - PLANNERS

111 Cameron Road, Tauranga, New Zealand
 P.O. Box 231 Ph.(07)577-6069
 Fax.(07)577-6065
 Email: slconsultants@sltga.co.nz

TITLE

THE LAKES

Stages 2D(Part), 2G, 2J
 2K, 2L & 2M

Geotechnical Report
 Reference Plan


(Sheet 2 of 3)

Copyright in this drawing is reserved

ORIGINAL SCALES	DATE
1:500 @ A1	08/08
1:1000 @ A3	

DRAWING No.

18264 - AB12





- Notes:
 1) Contours are in terms of Moturiki Datum
- Key
- Fill Compaction Test
 - ⊕ Pre-subdivision Test Site
 - ⊠ Settlement Control Marker
 - Post Earthwork Borehole
 - Subsoil Drain
 - Building Restriction Line
lots 520, 560, 561 & 562 See DP408042, other building restrictions on lots 565-570 are determined by underground services

4/ Analysed Cross Section



checked by	Rev. No.	Description	DATE	SIGNED
Surveyed				
Designed				
Drawn	GR		08/08	
Checked	CH		08/08	
Approved				

Issued with Report 08/08

REFERENCE



S & L CONSULTANTS LTD
 SURVEYORS - ENGINEERS - PLANNERS

111 Cameron Road, Tauranga, New Zealand
 P.O. Box 231 Ph.(07)577-6069
 Fax(07)577-6065
 Email: slconsultants@slta.co.nz

TITLE

THE LAKES

Stages 2D(Part), 2G, 2J
 2K, 2L & 2M

Geotechnical Report
 Reference Plan

(Sheet 3 of 3)

Copyright in this drawing is reserved

ORIGINAL SCALES	DATE
1:500 @ A3	08/08
1:1000 @ A3	


DRAWING NO.

18264 - AB13

REVISION

METRIC DESIGN

GRAPHIC SCALE

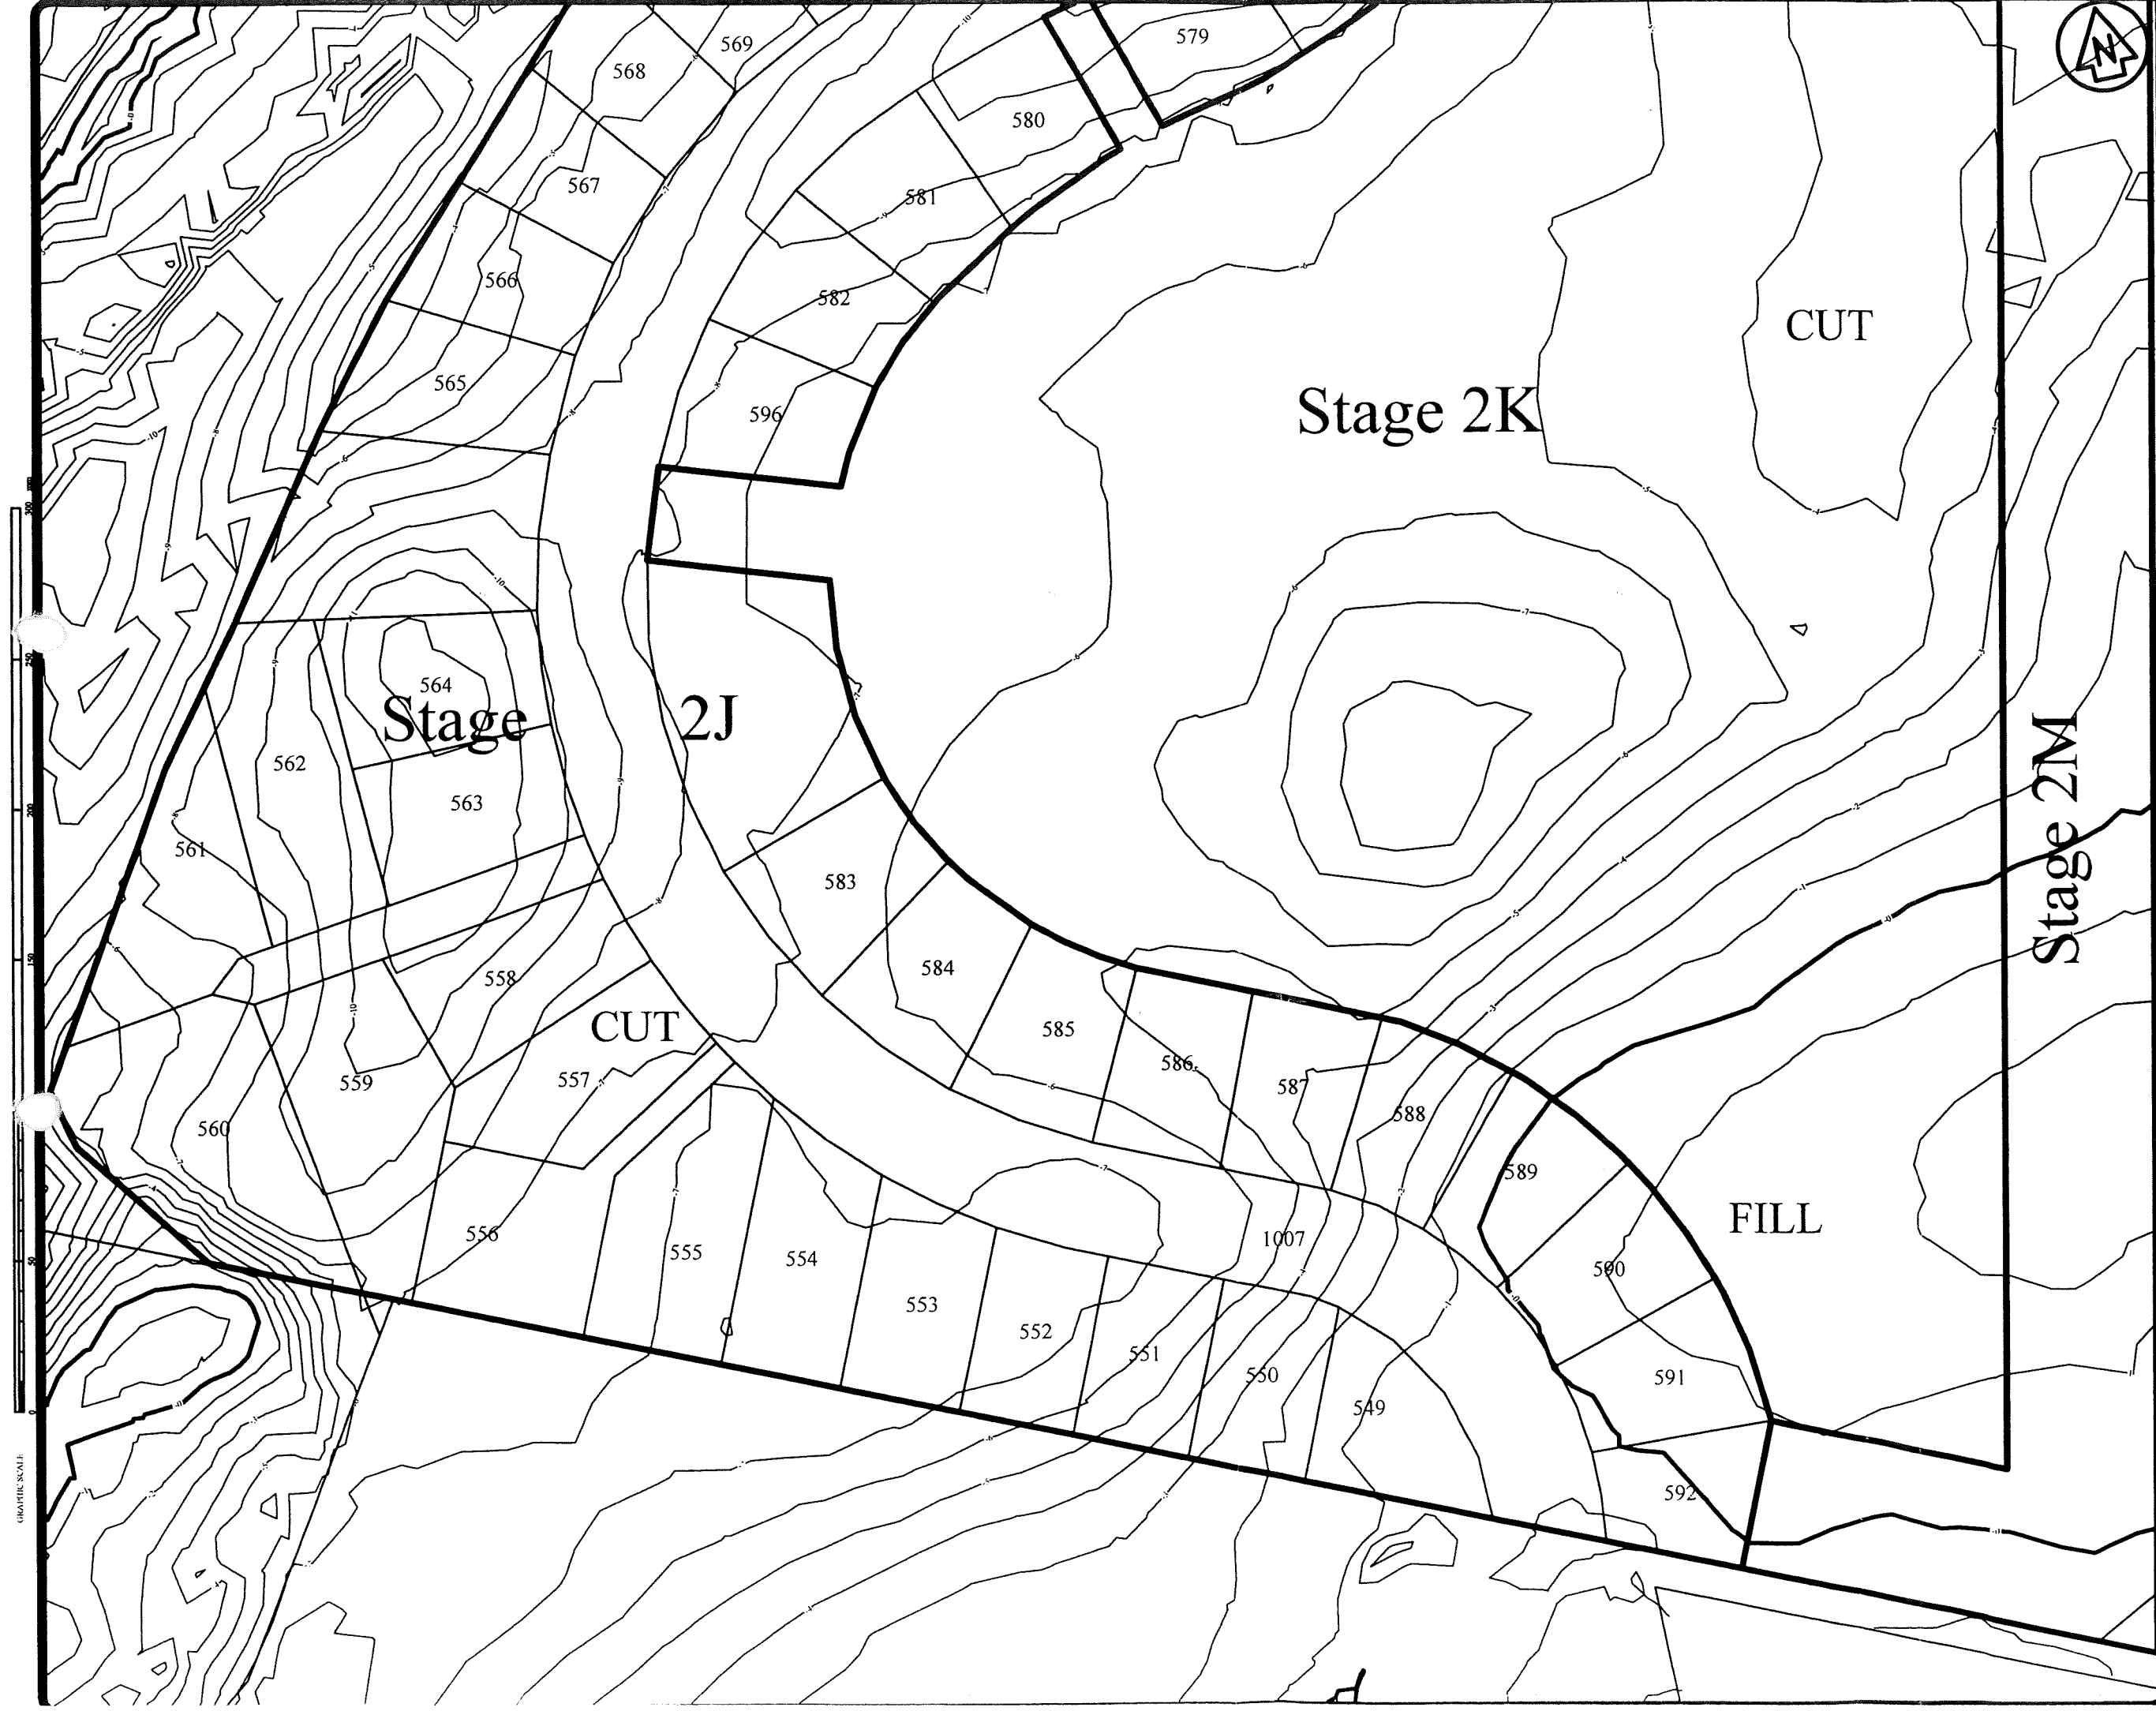

FILL Subdivision Cut and Fill Areas
 CUT
 — Fill Contour
 - - - Cut Contour

Checked by	Rev. No.	Description	DATE
	1	Issued with Report	08/08
Surveyed			
Designed			
Drawn	GR		08/08
Checked	CLF		08/08
Approved		<i>[Signature]</i>	

REFERENCES



S & L CONSULTANTS LTD
 SURVEYORS - ENGINEERS - PLANNERS

111 Cameron Road, Tauranga, New Zealand
 P.O. Box 231 Ph. (07)577-6069
 Fax (07)577-6065
 Email: slconsultants@sltga.co.nz

TITLE

THE LAKES

Stages 2D(Part), 2G, 2J
 2K, 2L & 2M

Cut Fill Plan
 (Sheet 1 of 3)

Copyright in this drawing is reserved

ORIGINAL SCALES
 1:500 @ A1
 1:1000 @ A3


DATE
 08.08

DRAWING No
 18264 - AB14

REVISION

METRIC DESIGN

GRAPHIC SCALE

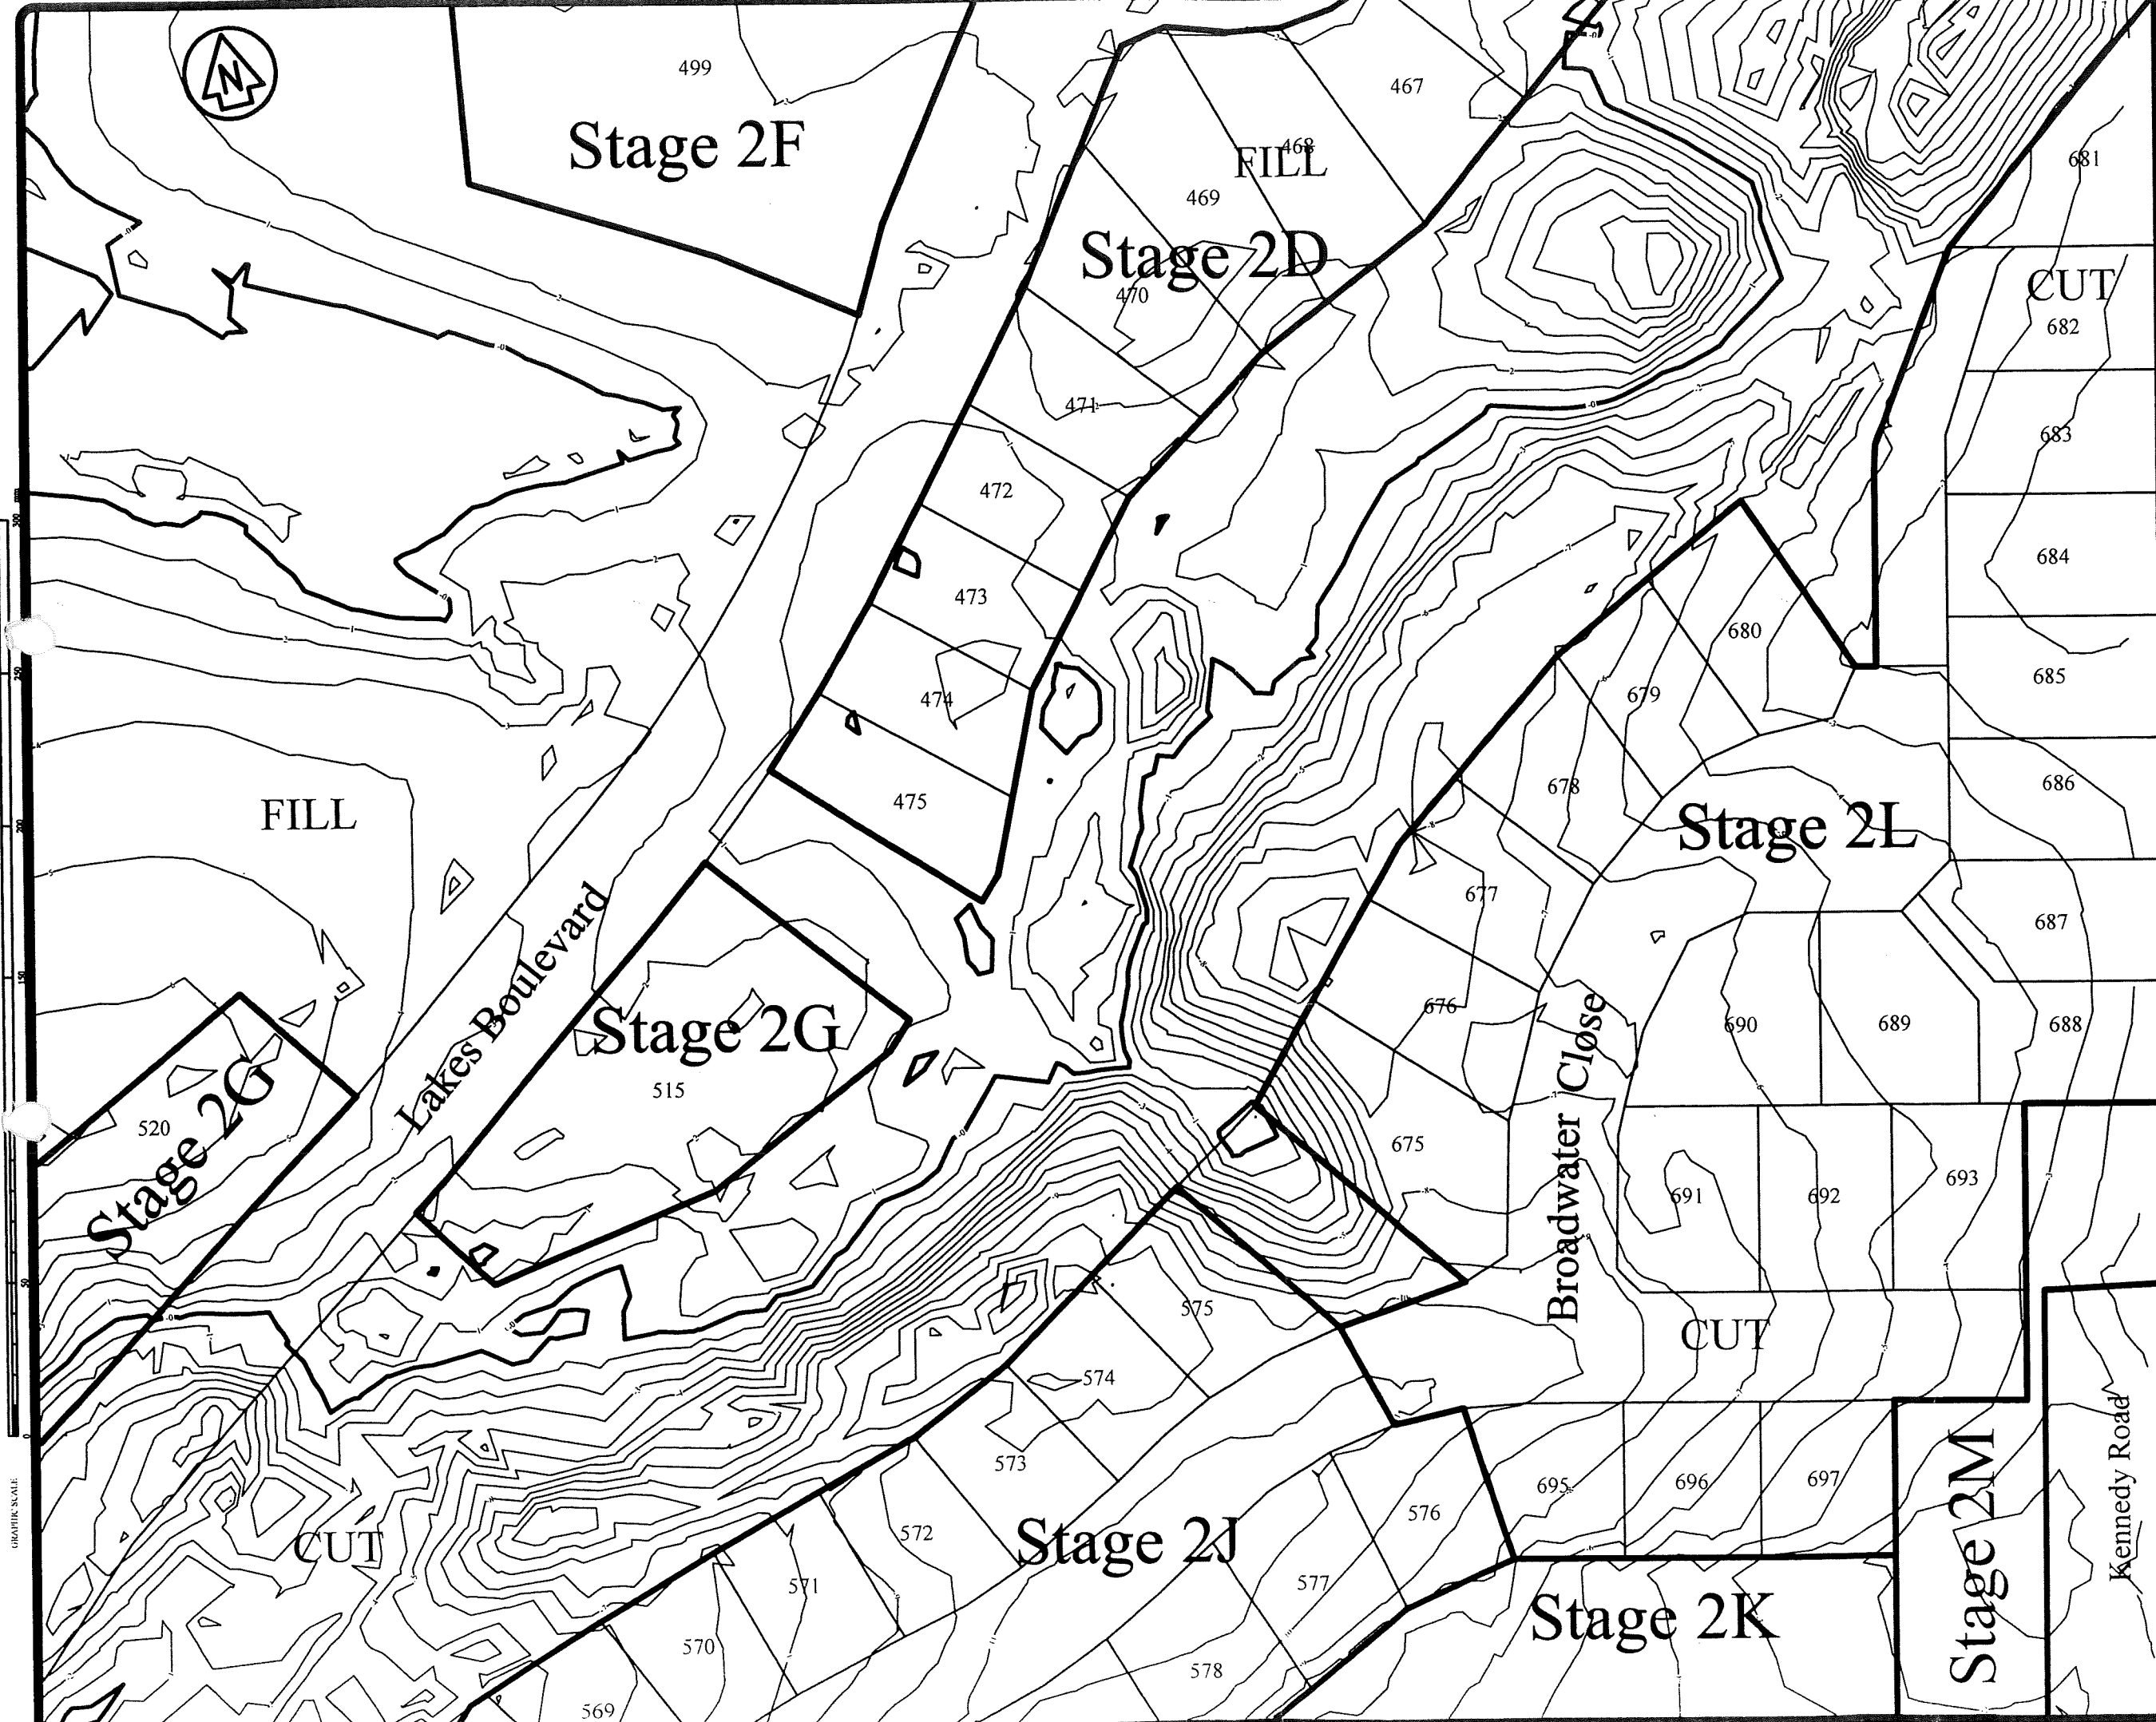

FILL Subdivision Cut and Fill Areas
 CUT
 — Fill Contour
 - - Cut Contour

Checked by	Rev. No.	Issued with Report		DATE
		NAME	DATE	
Surveyed				
Designed				
Drawn	GR	08/08		
Checked	CH	08/08		
Approved				

REFERENCES



S & L CONSULTANTS LTD
 SURVEYORS - ENGINEERS - PLANNERS
 111 Cameron Road, Tauranga, New Zealand
 P.O. Box 231 Ph.(07)577-6069
 Fax(07)577-6065
 Email: slconsultants@slta.co.nz

TITLE

THE LAKES

Stages 2D(Part), 2G, 2J
 2K, 2L & 2M
 Cut Fill Plan
 (Sheet 2 of 3)


Copyright in this drawing is reserved

ORIGINAL SCALES	DATE
1:500 @ A1	08.08
1:1000 @ A3	

DRAWING No.

18264 - AB15

GRAPHIC SCALE

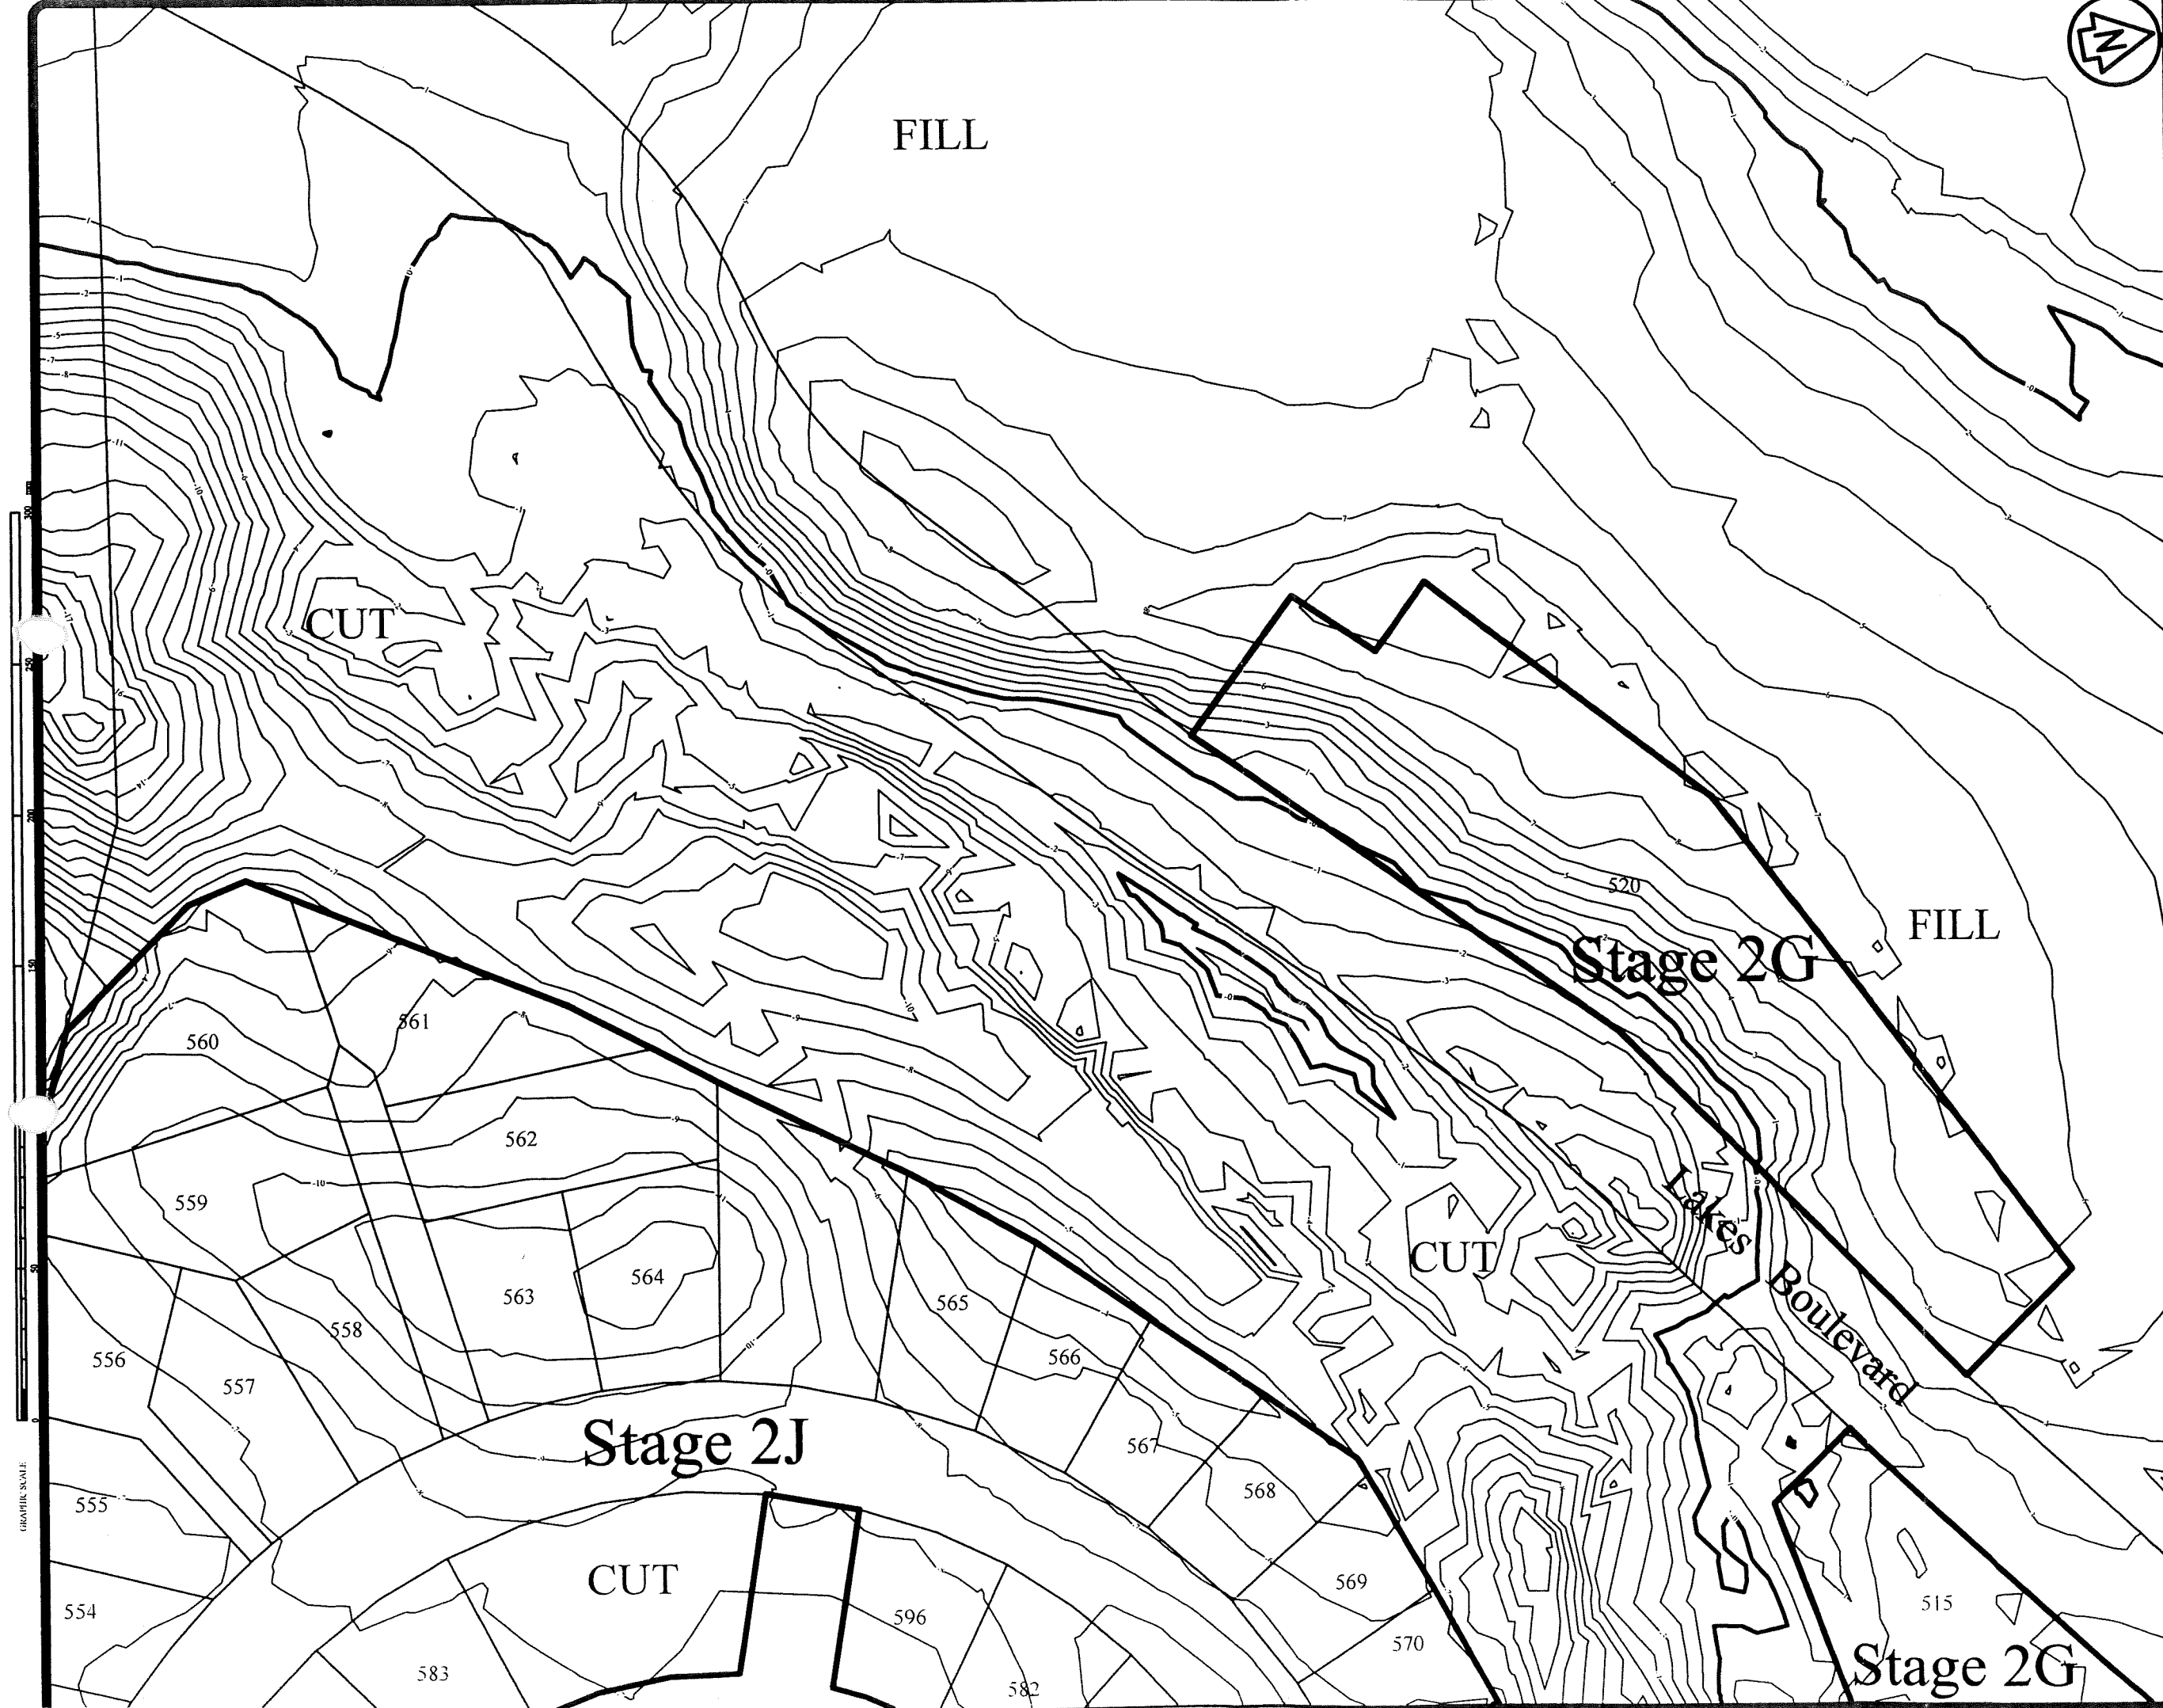

FILL Subdivision Cut and Fill Areas
 CUT
 — Fill Contour
 -|— Cut Contour

GRAPHIC SCALE

Checked By:	Rev. No.	Issued with Report		08/08
		Description		DATE
		NAME	DATE	SIGNED
Surveyed				
Designed				
Drawn	GR	08/08		
Checked	CH	08/08		
Approved	<i>[Signature]</i>			


REFERENCES



S & L CONSULTANTS LTD
 SURVEYORS - ENGINEERS - PLANNERS

111 Cameron Road, Tauranga, New Zealand
 P.O. Box 231 Ph. (07)577-6069
 Fax (07)577-6065
 Email: slconsultants@sltga.co.nz

TITLE



THE LAKES
LANDSCAPE ARCHITECTS


Stages 2D(Part), 2G, 2J
 2K, 2L & 2M
 Cut Fill Plan
 (Sheet 3 of 3)

Copyright in this drawing is reserved

ORIGINAL SCALE	DATE
1:500 @ A3 1:1000 @ A3	08.08
DRAWING No.	
18264 - AB16	

REVISION



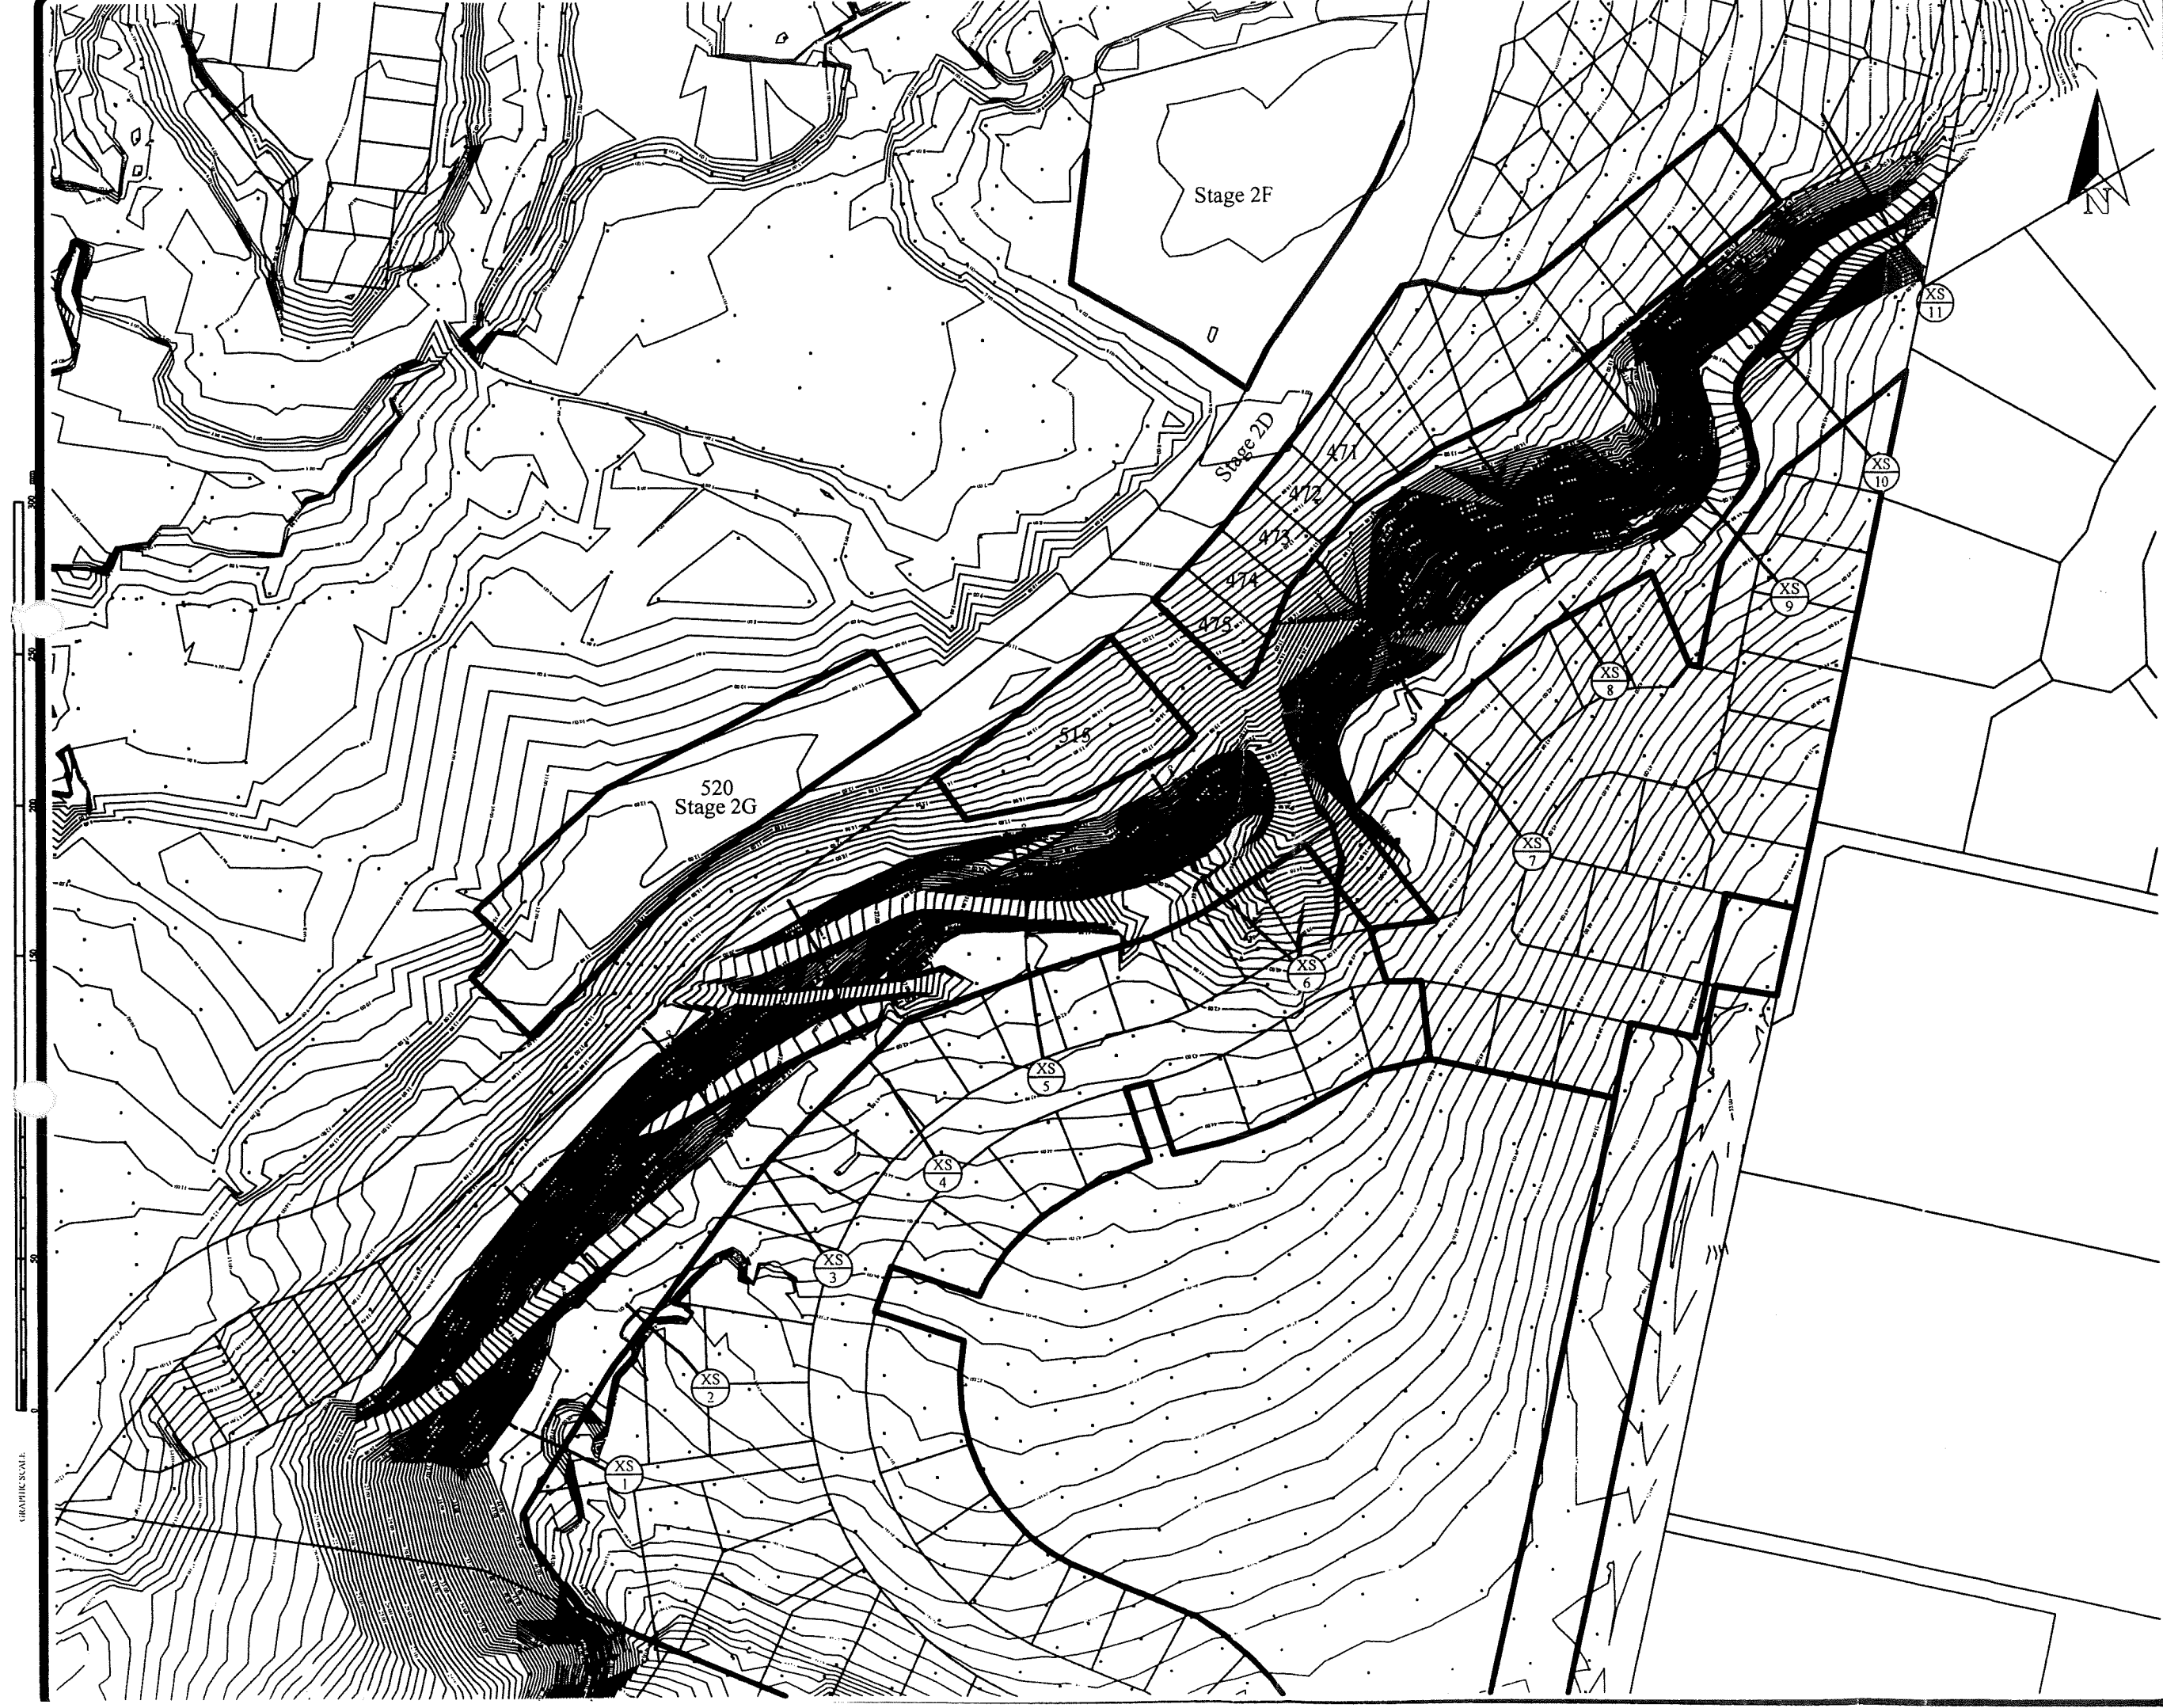

GRAPHIC SCALE


0	With Completion Report	08/08
checked by	Rev. No.	DATE
	NAME	SIGNED
Surveyed		
Designed		
Drawn	NP	29/5/07
Checked		
Approved	<i>[Signature]</i>	



S & L CONSULTANTS LTD
SURVEYORS - ENGINEERS - PLANNERS

111 Cameron Road, Tauranga, New Zealand
P.O. Box 231 Ph.(07)577-6069
Fax(07)577-6065
Email: sconsultants@sltga.co.nz

TITLE



THE LAKES

Stages 2D, 2G, 2J & 2L


Slope Contours
To Stages 2D, 2G Before
Earthworks

Copyright on this drawing is reserved


ORIGINAL SCALES	DATE
1:1000 @ A1	05.07
1:2000 @ A3	

DRAWING No.

18264 - 20





Key:
 S&L Borehole
 (Note: Locations of boreholes are described on the logs to relate to this drawing.)

Note:
 1) Levels are in terms of Moturiki Datum

0	Issue for Geotechnical Report	01/08
Checked by:	Description	DATE


REFERENCES



S & L CONSULTANTS LTD
 SURVEYORS - ENGINEERS - PLANNERS

111 Cameron Road, Tauranga, New Zealand
 P.O. Box 231 Ph.(07)577-6069
 Fax(07)577-6065
 Email: slconsultants@slga.co.nz

TITLE




THE LAKES
 Stages 2D, 2G, 2J, 2L
 Completed Slope Contours
 To Stages 2D, 2G

Copyright on this drawing is reserved

ORIGINAL SCALES	DATE
1:1000 @ A1	01/08
1:2000 @ A3	

DRAWING No:
 18264 - 21



GRAPHIC SCALE