


**NOTES**

- WORKS HAVE BEEN CARRIED OUT IN ACCORDANCE WITH RC 16780.
- ORIGIN OF LEVELS FOR SURVEY: TCC BM 1023 (BM 1023 DP 419065) RL=51.005 MOTURIKI DATUM.
- ALL WASTEWATER MAINS ARE 150mmØ NOVADRAIN (SN16) PIPE UNLESS SHOWN OTHERWISE.
- ALL LOT CONNECTIONS ARE 150mmØ RRJ NOVADRAIN (SN16) PIPE UNDER ROADS UNLESS SHOWN OTHERWISE.
- ALL 100mmØ PIPE IS RRJ NOVADRAIN (SN16) PIPE UNLESS SHOWN OTHERWISE.
- ABANDONED LOT CONNECTIONS HAVE BEEN CAPPED WITHIN THE ROAD RESERVE.
- PLEASE REFER TO ELECTRONIC ASBUILTS FOR FURTHER INFORMATION.

**LEGEND:**

- WASTEWATER
- - - EXISTING WASTEWATER
- MANHOLE
- EXISTING MANHOLE
- FLOW DIRECTION

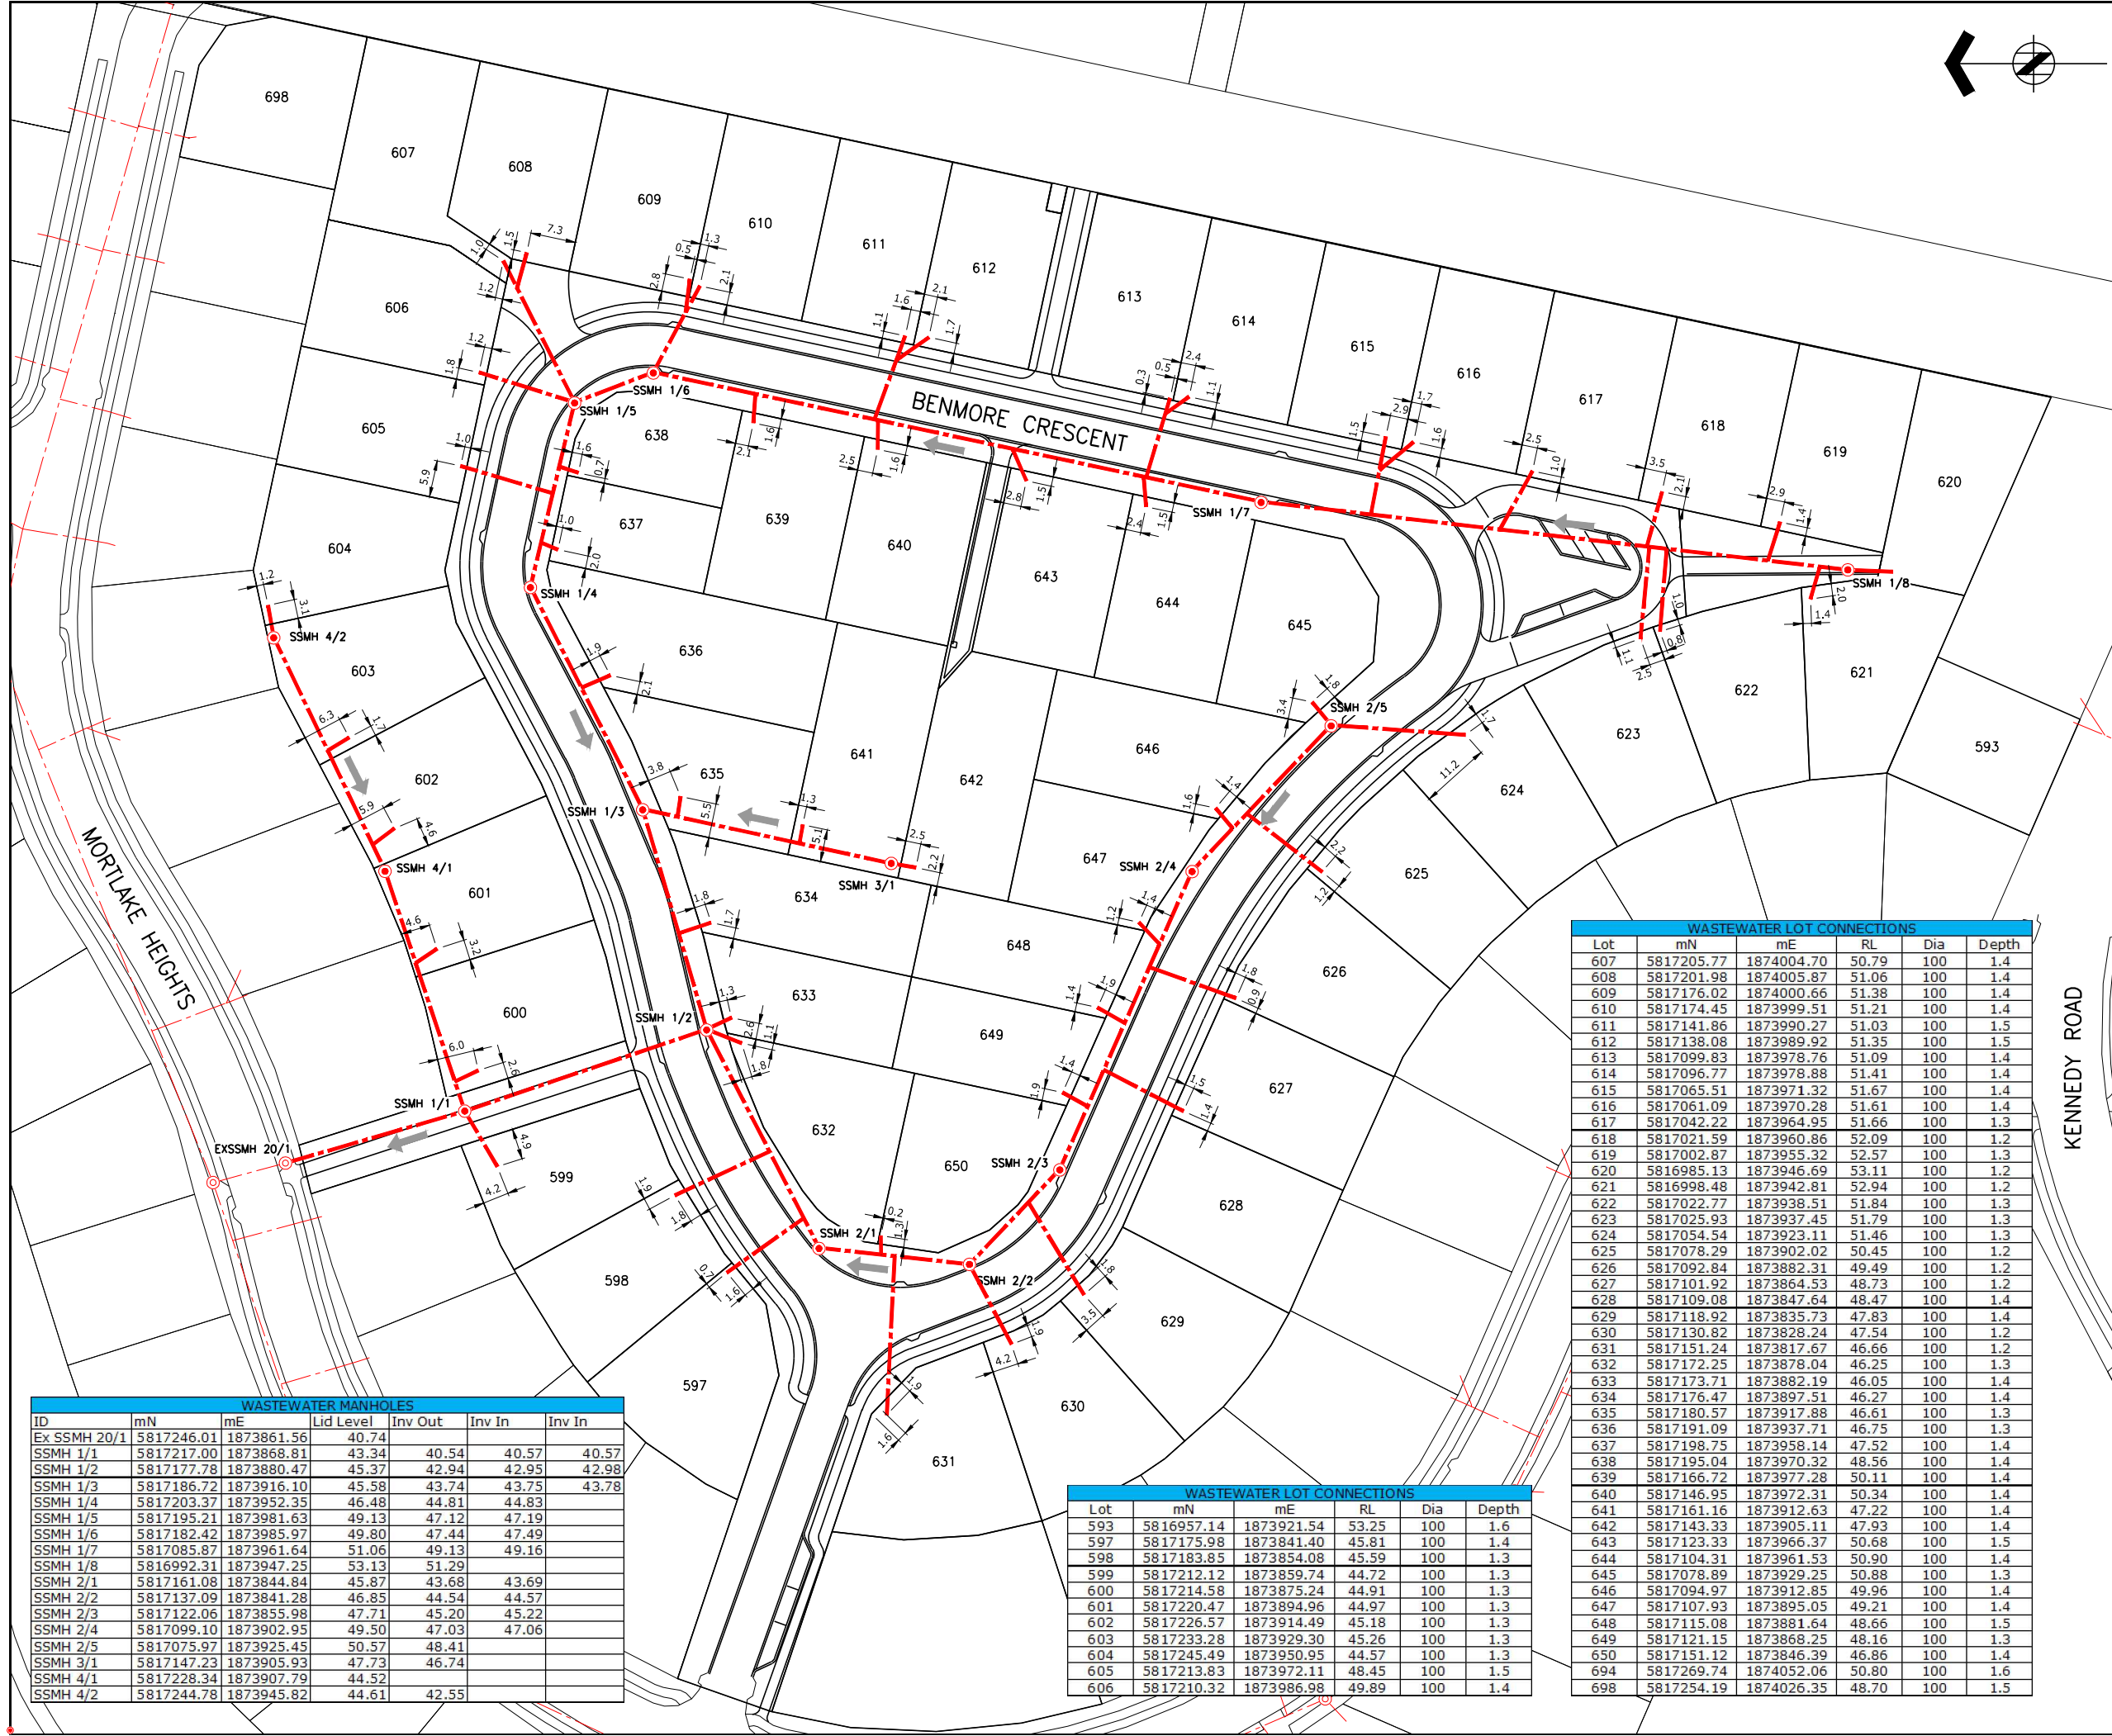

WASTEWATER MANHOLES						
ID	mN	mE	Lid Level	Inv Out	Inv In	Inv In
Ex SSMH 20/1	5817246.01	1873861.56	40.74			
SSMH 1/1	5817217.00	1873868.81	43.34	40.54	40.57	40.57
SSMH 1/2	5817177.78	1873880.47	45.37	42.94	42.95	42.98
SSMH 1/3	5817186.72	1873916.10	45.58	43.74	43.75	43.78
SSMH 1/4	5817203.37	1873952.35	46.48	44.81	44.83	
SSMH 1/5	5817195.21	1873981.63	49.13	47.12	47.19	
SSMH 1/6	5817182.42	1873985.97	49.80	47.44	47.49	
SSMH 1/7	5817085.87	1873961.64	51.06	49.13	49.16	
SSMH 1/8	5816992.31	1873947.25	53.13	51.29		
SSMH 2/1	5817161.08	1873844.84	45.87	43.68	43.69	
SSMH 2/2	5817137.09	1873841.28	46.85	44.54	44.57	
SSMH 2/3	5817122.06	1873855.98	47.71	45.20	45.22	
SSMH 2/4	5817099.10	1873902.95	49.50	47.03	47.06	
SSMH 2/5	5817075.97	1873925.45	50.57	48.41		
SSMH 3/1	5817147.23	1873905.93	47.73	46.74		
SSMH 4/1	5817228.34	1873907.79	44.52			
SSMH 4/2	5817244.78	1873945.82	44.61	42.55		

WASTEWATER LOT CONNECTIONS					
Lot	mN	mE	RL	Dia	Depth
593	5816957.14	1873921.54	53.25	100	1.6
597	5817175.98	1873841.40	45.81	100	1.4
598	5817183.85	1873854.08	45.59	100	1.3
599	5817212.12	1873859.74	44.72	100	1.3
600	5817214.58	1873875.24	44.91	100	1.3
601	5817220.47	1873894.96	44.97	100	1.3
602	5817226.57	1873914.49	45.18	100	1.3
603	5817233.28	1873929.30	45.26	100	1.3
604	5817245.49	1873950.95	44.57	100	1.3
605	5817213.83	1873972.11	48.45	100	1.5
606	5817210.32	1873986.98	49.89	100	1.4

WASTEWATER LOT CONNECTIONS					
Lot	mN	mE	RL	Dia	Depth
607	5817205.77	1874004.70	50.79	100	1.4
608	5817201.98	1874005.87	51.06	100	1.4
609	5817176.02	1874000.66	51.38	100	1.4
610	5817174.45	1873999.51	51.21	100	1.4
611	5817141.86	1873990.27	51.03	100	1.5
612	5817138.08	1873989.92	51.35	100	1.5
613	5817099.83	1873978.76	51.09	100	1.4
614	5817096.77	1873978.88	51.41	100	1.4
615	5817065.51	1873971.32	51.67	100	1.4
616	5817061.09	1873970.28	51.61	100	1.4
617	5817042.22	1873964.95	51.66	100	1.3
618	5817021.59	1873960.86	52.09	100	1.2
619	5817002.87	1873955.32	52.57	100	1.3
620	5816985.13	1873946.69	53.11	100	1.2
621	5816998.48	1873942.81	52.94	100	1.2
622	5817022.77	1873938.51	51.84	100	1.3
623	5817025.93	1873937.45	51.79	100	1.3
624	5817054.54	1873923.11	51.46	100	1.3
625	5817078.29	1873902.02	50.45	100	1.2
626	5817092.84	1873882.31	49.49	100	1.2
627	5817101.92	1873864.53	48.73	100	1.2
628	5817109.08	1873847.64	48.47	100	1.4
629	5817118.92	1873835.73	47.83	100	1.4
630	5817130.82	1873828.24	47.54	100	1.2
631	5817151.24	1873817.67	46.66	100	1.2
632	5817172.25	1873878.04	46.25	100	1.3
633	5817173.71	1873882.19	46.05	100	1.4
634	5817176.47	1873897.51	46.27	100	1.4
635	5817180.57	1873917.88	46.61	100	1.3
636	5817191.09	1873937.71	46.75	100	1.3
637	5817198.75	1873958.14	47.52	100	1.4
638	5817195.04	1873970.32	48.56	100	1.4
639	5817166.72	1873977.28	50.11	100	1.4
640	5817146.95	1873972.31	50.34	100	1.4
641	5817161.16	1873912.63	47.22	100	1.4
642	5817143.33	1873905.11	47.93	100	1.4
643	5817123.33	1873966.37	50.68	100	1.5
644	5817104.31	1873961.53	50.90	100	1.4
645	5817078.89	1873929.25	50.88	100	1.3
646	5817094.97	1873912.85	49.96	100	1.4
647	5817107.93	1873895.05	49.21	100	1.4
648	5817115.08	1873881.64	48.66	100	1.5
649	5817121.15	1873868.25	48.16	100	1.3
650	5817151.12	1873846.39	46.86	100	1.4
694	5817269.74	1874052.06	50.80	100	1.6
698	5817254.19	1874026.35	48.70	100	1.5

**HARRISON GRIERSON**  
 Tauranga Office  
 Level 1 Harrison Grierson House  
 141 Cameron Road Tauranga 3110  
 P +64 7 578 0023  
 www.harrisongrierson.com

A	AS-BUILT	GPR	09.04.13
REF	REVISIONS	BY	DATE
PROJECT:			

**THE LAKES (2012) LTD  
 TAURANGA**

**STAGE 2K  
 WASTEWATER  
 AS-BUILT PLAN**

ORIGINATOR:	DATE:	SIGNED:	PLOT BY:
RCH	26.03.13		HJD
DRAWN:	DATE:	SIGNED:	PLOT DATE:
HJD	26.03.13		09.04.13
CHECKED:	DATE:	SIGNED:	SURVEY BY:
GPR	09.04.13		
APPROVED:	DATE:	SIGNED:	SURVEY DATE:
DGN	09.04.13		
ISSUE STATUS:			
<b>AS-BUILT</b>			

PROJECT No:	1520-132631-01	SCALE:	1:500 - A1 1:1000 - A3	REV	A1
DRAWING No:	<b>132631-2K-AB200</b>			REV	<b>A</b>