

NOTES

- WORKS HAVE BEEN CARRIED OUT IN ACCORDANCE WITH RC 16780.
- ORIGIN OF LEVELS FOR SURVEY: TCC BM 1026 (BM 1023 DP 419065) RL=51.005 MOTURIKI DATUM.
- PLEASE REFER TO ELECTRONIC AS BUILTS FOR FURTHER INFORMATION.

LEGEND

- STREET SIGN
- STREET LIGHT
- TCC BENCHMARK
- CONCRETE FOOTPATH "RIVERLEA GOLD"
- CONCRETE ACCESS "HALF BLACK EXPOSED AGGREGATE"
- KERB LINE AND REFERENCE
- PAVEMENT DEPTH EXTENTS

HARRISON GRIERSON
 Tauranga Office
 Level 1 Harrison Grierson House
 141 Cameron Road Tauranga 3110
 P +64 7 578 0023
 www.harrisongrierson.com

REF	REVISIONS	BY	DATE
A	AS-BUILT	GPR	09.04.13


PROJECT:
**THE LAKES (2012) LTD
 TAURANGA**

TITLE:
**STAGE 2K
 STREETScape AND TRANSPORTATION
 AS-BUILT PLAN**

ORIGINATOR: RCH	DATE: 02.04.13	SIGNED:	PLOT BY: HJD
DRAWN: HJD	DATE: 02.04.13	SIGNED:	PLOT DATE: 09.04.13
CHECKED: GPR	DATE: 09.04.13	SIGNED:	SURVEY BY:
APPROVED: DGN	DATE: 09.04.13	SIGNED:	SURVEY DATE:

ISSUE STATUS:
AS-BUILT

PROJECT No: 1520-132631-01	SCALES: 1:500 - A1 1:1000 - A3	DRAWING No: 132631-2K-AB400	REV A
-------------------------------	--------------------------------------	---------------------------------------	-----------------

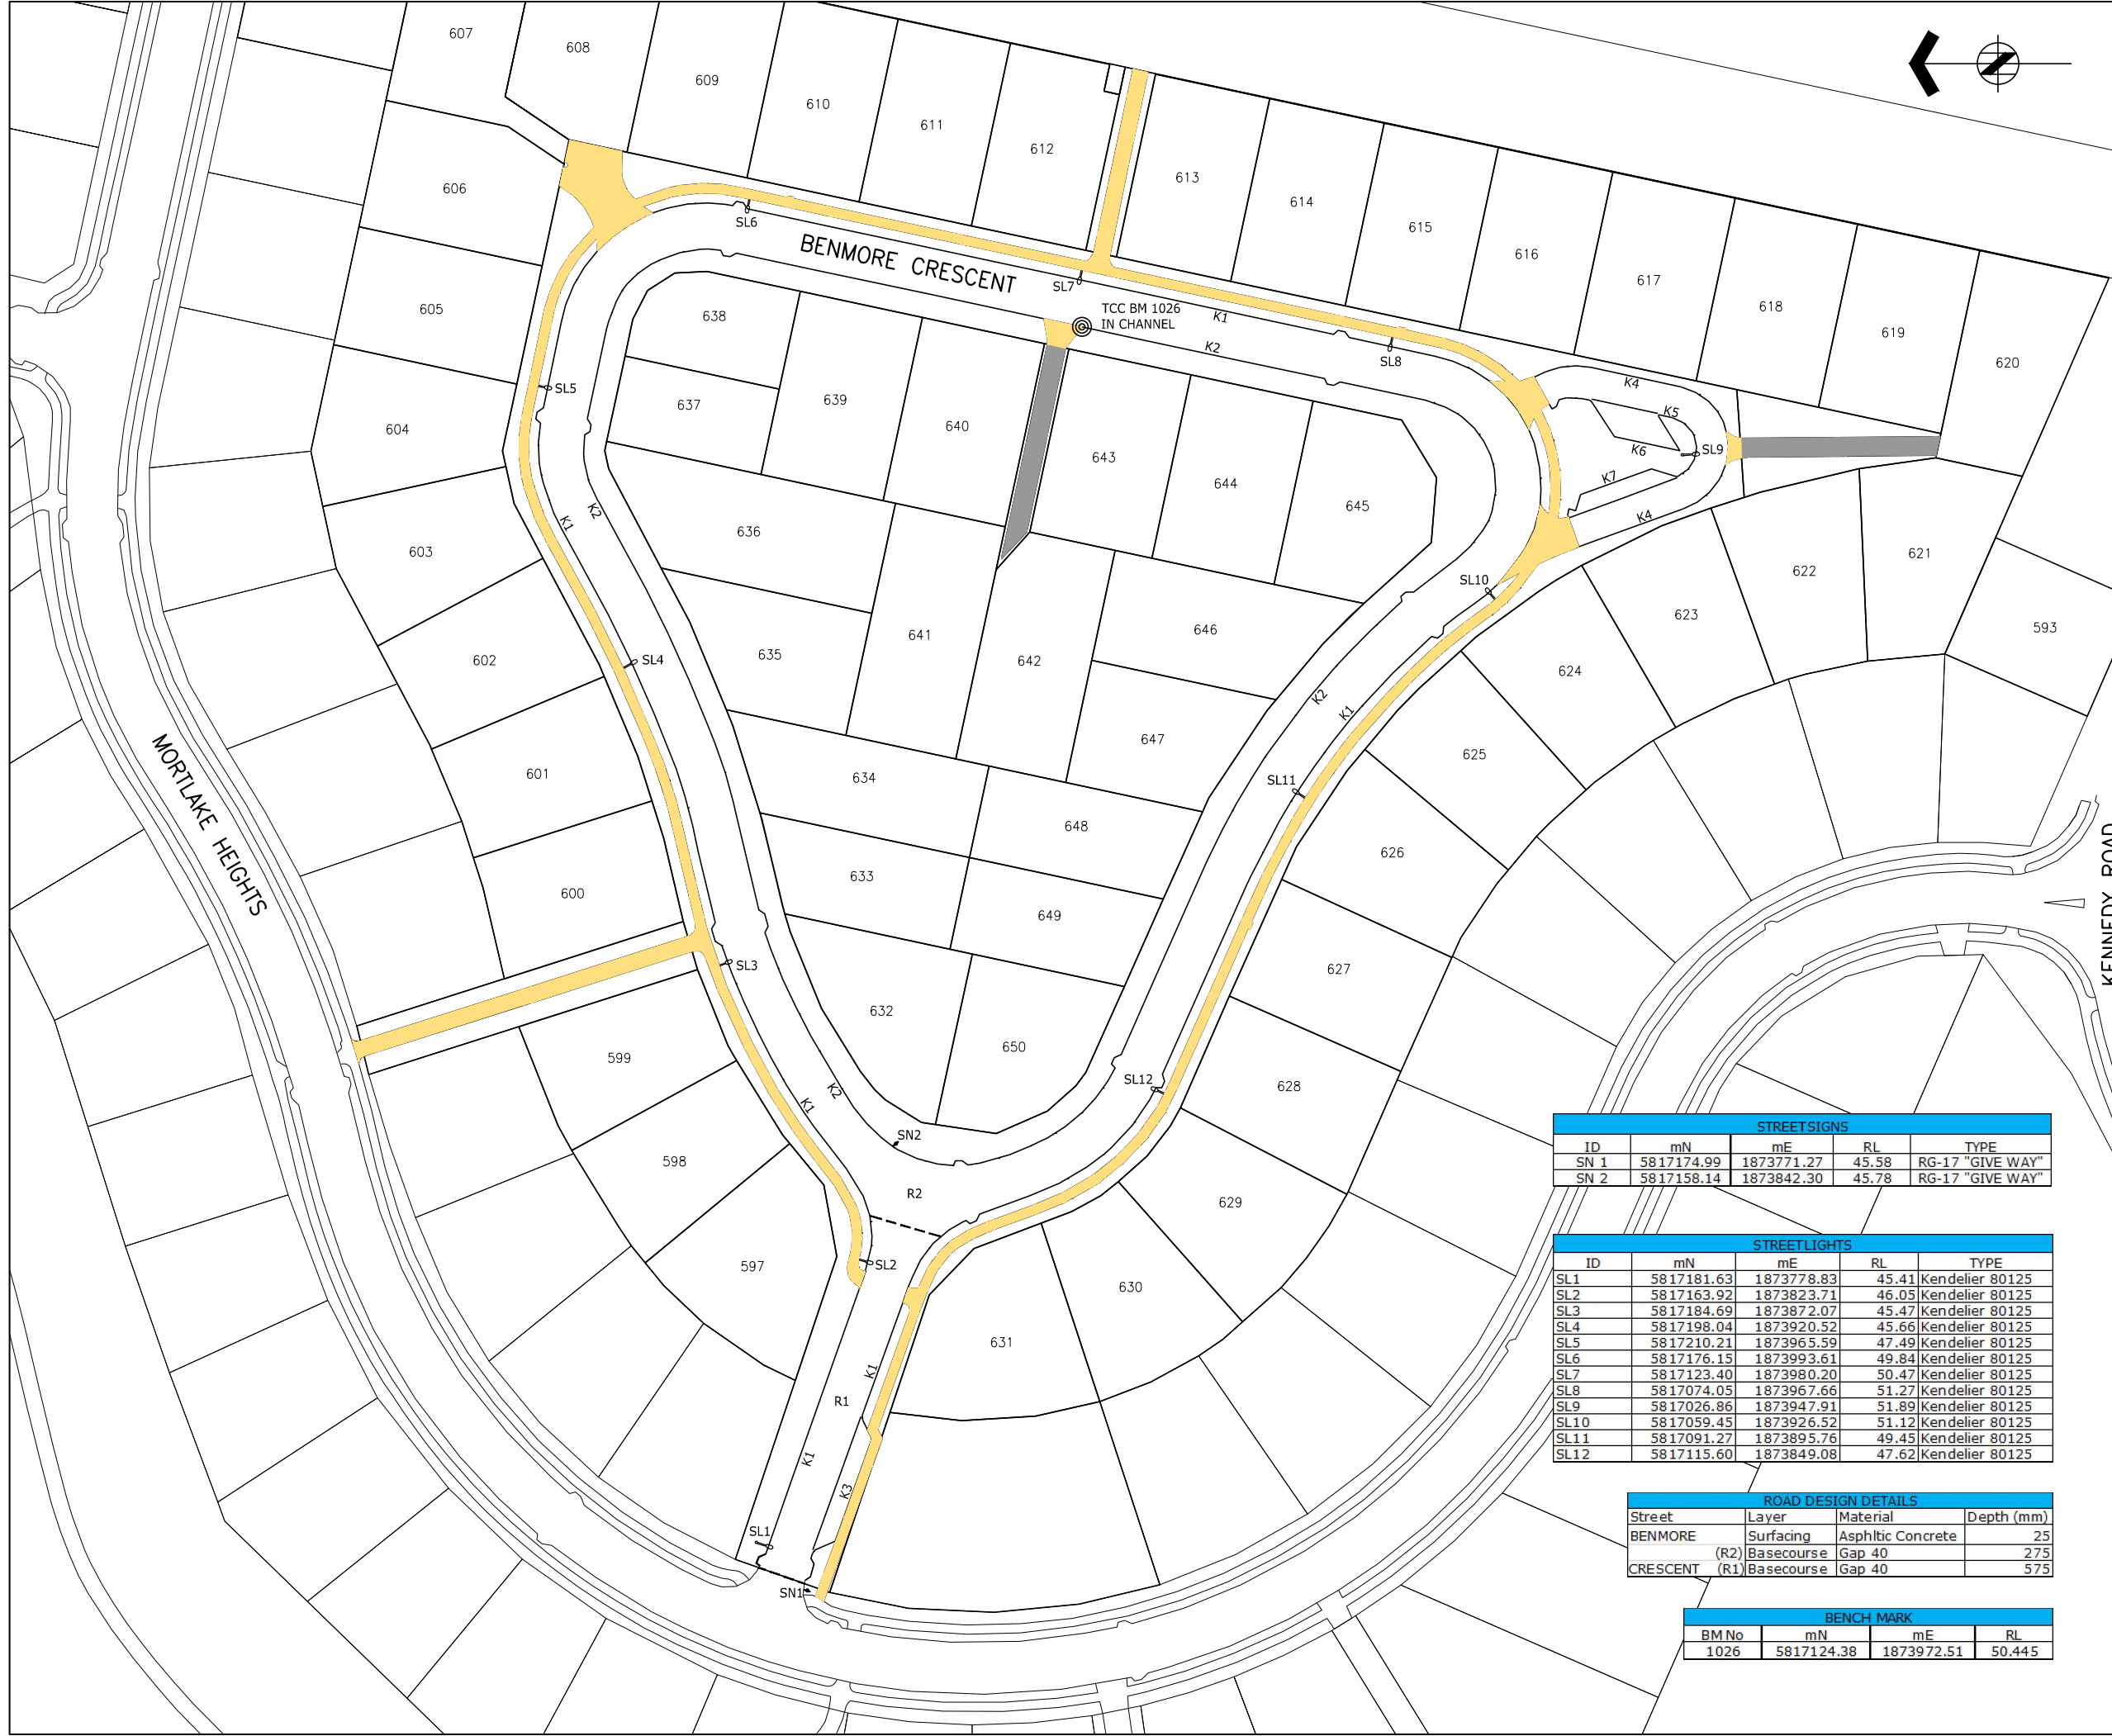

STREET SIGNS				
ID	mN	mE	RL	TYPE
SN 1	5817174.99	1873771.27	45.58	RG-17 "GIVE WAY"
SN 2	5817158.14	1873842.30	45.78	RG-17 "GIVE WAY"

STREET LIGHTS				
ID	mN	mE	RL	TYPE
SL1	5817181.63	1873778.83	45.41	Kendelier 80125
SL2	5817163.92	1873823.71	46.05	Kendelier 80125
SL3	5817184.69	1873872.07	45.47	Kendelier 80125
SL4	5817198.04	1873920.52	45.66	Kendelier 80125
SL5	5817210.21	1873965.59	47.49	Kendelier 80125
SL6	5817176.15	1873993.61	49.84	Kendelier 80125
SL7	5817123.40	1873980.20	50.47	Kendelier 80125
SL8	5817074.05	1873967.66	51.27	Kendelier 80125
SL9	5817026.86	1873947.91	51.89	Kendelier 80125
SL10	5817059.45	1873926.52	51.12	Kendelier 80125
SL11	5817091.27	1873895.76	49.45	Kendelier 80125
SL12	5817115.60	1873849.08	47.62	Kendelier 80125

ROAD DESIGN DETAILS			
Street	Layer	Material	Depth (mm)
BENMORE	Surfacing	Asphaltic Concrete	25
CRESCENT (R2)	Basecourse	Gap 40	275
CRESCENT (R1)	Basecourse	Gap 40	575

BENCH MARK			
BM No	mN	mE	RL
1026	5817124.38	1873972.51	50.445